


7-39

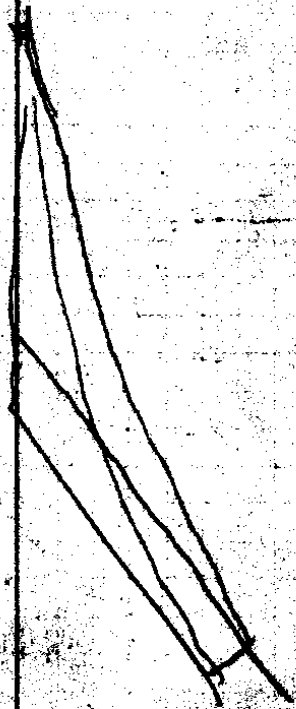

J Will Buckley

Δ 10

2085

Δ 9A

off mt 5 East

A 9

4-20 2444

2437

Δ 8

11 300

505  
294.5 345.0

Δ 7

11 2915

286 L

Δ 7-6

1183

6

8 5 1700

1693

5545

0-47 No 10'w

Δ 4

off mt 12 East

Δ 3

02 28 3000  
40 19189

381 E

1/4 2685

2673

1/4 24 29

274.8

North

off set 20 cent  
From corner = 1A

29  
4  
28

Recorded.

22-5

Found old BO Tree stump  
mark but down also found  
W, O, & at scale in the ground

Marked 24" From S77W 27 FT  
" 24" " S59E 66" " 14'.

CS 7/39

J. Will Buckley

Δ 5 E

3 238.2

238.2

Δ 4 E A

263.5

Δ 4 E

off net 550  
478.2

24-20 190.3

173.2

Δ 3 E

20-20 135.4

126.8

Δ 2 E A

off net 5 North

Δ 2 E

9-30 103.2

102.2

Δ 1 E

10 77.2

76.2

Cast

Δ 7 A

Turned Safeland,  
 Turn center  
 into 0  
 70° ← 82° → 517-30E  
 code line

8  
 89-03  
 DTA → 41E

Back sight on 8th N Line  
 turn

CLENN 7/39

