


McCAMES
1598.5 P₇ Div to Head Pond

Pick up on #4 - B.S. on #3

C. S. TRIG INC.

7/54

Yew wood stake

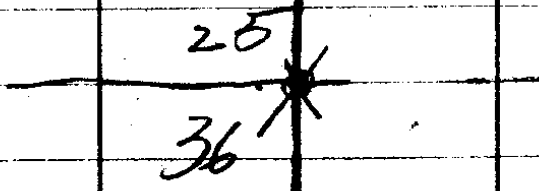

F W 10" S 80W 5.5 feet

" 6" N 75W 15 feet

N 75E 12 feet
Wolford #1

Lot 2 So Side N Viny R,
Sec 19 T26S R3W.

+

Deed descr. Osborne to C Hill

Walt Osborne

Sta.	chs.	✓	CC	MC	Slope
30.801	4.535	2 56, 1028 R	N 7° 8' E	N 7° E	-1350' 1622 3.000
20.668	3.452	4 57, 2 24 R	N 5° 40' E	N 6° E	-610' 3.472
20.814	2.176	0° 11' L	N 3° 44' E	N 2° 4' E	--
20.698	5.251	11 17, 5° 38 1/2 R	N 3° 22 1/2 E	N 3° 1/2 E	-6° 20' 281 5.000
15.347	2.610	29 9, 24° 35' R	N 2° 10' W	N 2° 4' W	-20° 35' 2788
10.777	2.611	54 29, 27° 14' L	N 26° 10' W	N 27° 3/4 W	-26° 30' 2920
10.166	2.951	25 0° 13' R	N 0° 23 1/2 E	N 1/4 E	3° 35' 2952
7.247 Hub 2	3.005	19, 0° 10' R	N 0° 10' E	N 1/2 E	-3° 30' 3.011
Hub 1	4.210		N	N	-4° 30' 4.223
1/4 Cor.	24/19				
			Var. 21° E		

4535
1622
97100 - 2913

250 back hills so fence
comes in from west
99421

242 back of hab 6 - opp fence coming in from w.

99390

93616

89423

99822

99813

99692

One Orig BT standing chopped out
Post set by Cole standing Oak BT set by Cole
dying. Blazed & scribed Fir 16" dia 543' w 201h
1/4 s 24' to BT Drive 1' x 16" bar
along side Cole's Post.

May 24 1929

Stowers

BB Irving T
Bert Lane
Gene Richardson } ch.
Allen Moore - Flag.

99421 7
3422 7

1988 42
6959 47
9768 4
28263
345189 712

971
2913

9939

49695
281
5251

93616 7
2788 7

728928
748928
655312
187232

89423
2422
178846
804507
178846

26111512

99822 34
2956

598932
499110
898398
199684
295073832

99813
3011

1097943
299439
300536943

99692 4
4223

299076
199384
199384
398768
420999316

C. S. File No. 7/54

C1 Co Rd.

10,907

S 36° 38' E

4 Co Rd

48° 26' L

1.163

S 7° 8' W

9

See Cor ^{13 18}/_{17 19}

1245

N 11° 25' W N 11 1/2 W

1 ✓
20,339

34° 51' L

1795

N 23° 25' E N 23° E

11
38,403

4,617
~~4,515~~

4030
21° 15' R

N 2° 10' E N 1 1/2 E 4018' 4550

10

1247
6° 24' R

3,125

N 4° 18' W N 3 1/4 W

9
39801

1247
11° 21' L

N 7° 0' E

27	14 ✓	10 ✓
	11 ✓	13 ✓
	25	24 35 ✓
		538 ✓
		6 19 ✓
		1 28 ✓
		34 33
		27 25
		7 8

99719
Across N U mp - R

99719	8
498592	5
498595	
398876	
45372145	

C. S. File No. 7/54

Ash Tree on E Bank

7401

1600

$12^{\circ}5'$ 1.640

Hub 2

224

Hub 1

3.551

$-8^{\circ}30'$ 3.570

1/165 Cor

1.192

E

Hub

0.180

N

6

$53^{\circ}11'$ W

7

21
16 60

525

33571
20.526
<hr/>
13025
5.225
<hr/>
65225
26090
<hr/>
68495
68496

97784

36 1/4 ahead of the 2 - 4 Cor Road

98902

Drove 3/4 x 36 GIP

Fin 20' N 32° W 60

1/16 Blazed & Set N 1/16 S 24 CSBT

Fin 12' N 58 3/4° E 27

N 1/16 S 19 CSBT

C. S. File No. 9/34

Corner. 12' Forked North on Rt bank.

North Umpqua. Marked in bark

SW. Cor - C.S. BT

16' Maple. N47°W. 90 lks. C.S. BT.

20' Maple N 76°E N¹⁶⁰ C.S. BT

Cor. Sec $\frac{13}{24} \frac{18}{30}$ T 26SR 3+4W.
N E lks.

Deed Description of
Home place for Walt Osborn

3 rd Cor -					
	19,275		S 39°13'40"		
Hub		30°45' R	39°13'40"		
	2910		S 9°28' W	S 7°34' W	
off back line Hub		39°10' L			
	3,662		S 47°38' W	S 47° W	-14°21' 3780
Hub		10°24' R			
	1587		S 37° 49' W	S 37° W	-21°54' 1710
NW Cor.		52°58' L			
<hr/>					
SW Cor					
		50°48' L	S 39°12' W	S 39° W	
NW Cor S.O. 08	2,404				L 1897 -12°19' 1850
POT					
	1,029				
POT					
	1575			W	+11°21' 1600
Final Cor					

1480
41475
19.275

90
50
39

45
747
0012
5
0060

711/2 Back to oak line tree along line chain

96880

92784

30.17
22.41

92265

Var 20°

9688
328
77504
67816
29064
3662064
92784
121
92784
649488
92784
15866064

92265
185
461325
738120
92265
17059025
617
2404

98044
1604
5882540
9804540
15745864

C. S. File No. 754

1
Beginning at a point on the
meander line of the ~~Right~~^{Right} bank of the
North Umpqua River, said point
being $N 55^{\circ} 24' E$ 32.16 chains from
the Section Corner 13-18-19+2+ T26S
R3+4W WM.

Thence West 10.00 Chains

Thence West 5.01 Chains to a
1" x 48" pipe driven - 36" into ground.

Thence $S 39^{\circ} 12' W$ 25.27 Chains
to a 6 and 10" double myrtle on the
Right Bank of the North Umpqua
River said myrtle being marked
SW Cor CS BT and from which
a 16" maple bears $N 47^{\circ} W$ 90 lks and
a 20" " " $N 76^{\circ} E$ 160 lks
both blazed and marked CS BT
and the ^{aforsaid} section corner 13-18-19+2+
bears $N 78^{\circ} 25' E$ 356 lks.

Thence following the meander
line of the ~~North Umpqua~~ Right bank
of the North Umpqua River upstream
to the place of beginning ~~at~~

Beginning at a point on the
meander line of the ~~Left~~ bank of
the North Umpqua River said point
being $N 55^{\circ} 24' E$ 32.16 Chs from the
section corner 13-18-19-24 T26S R37W
W. W. M.

Thence West 10.00 chains

Thence West 5.01 Chs

Thence $S 39^{\circ} 22' W$ 25.27 Chs.

The aforesaid section cor 13-18-19-24 bears $N 78^{\circ} 3' E$ 356

to a 12 forked maple tree, marked
SW cor CS and from which

a 16" Maple bears $N 47^{\circ} W$ 90 lbs blazed
and marked CS BT,

a 20" Maple bears $N 76^{\circ} E$ 160 lbs blazed
and marked CS BT.

Thence following the meander line
of the ~~Left~~ ^{Right} bank
of the North Umpqua River upstream
to the point of beginning.

NO 8th W 4.6 lbs.

9 E 32 lbs.

CS FILE FOLDER

CONTAINS

MORE

INFORMATION