


J. S. McDonald

Apr. 20-39

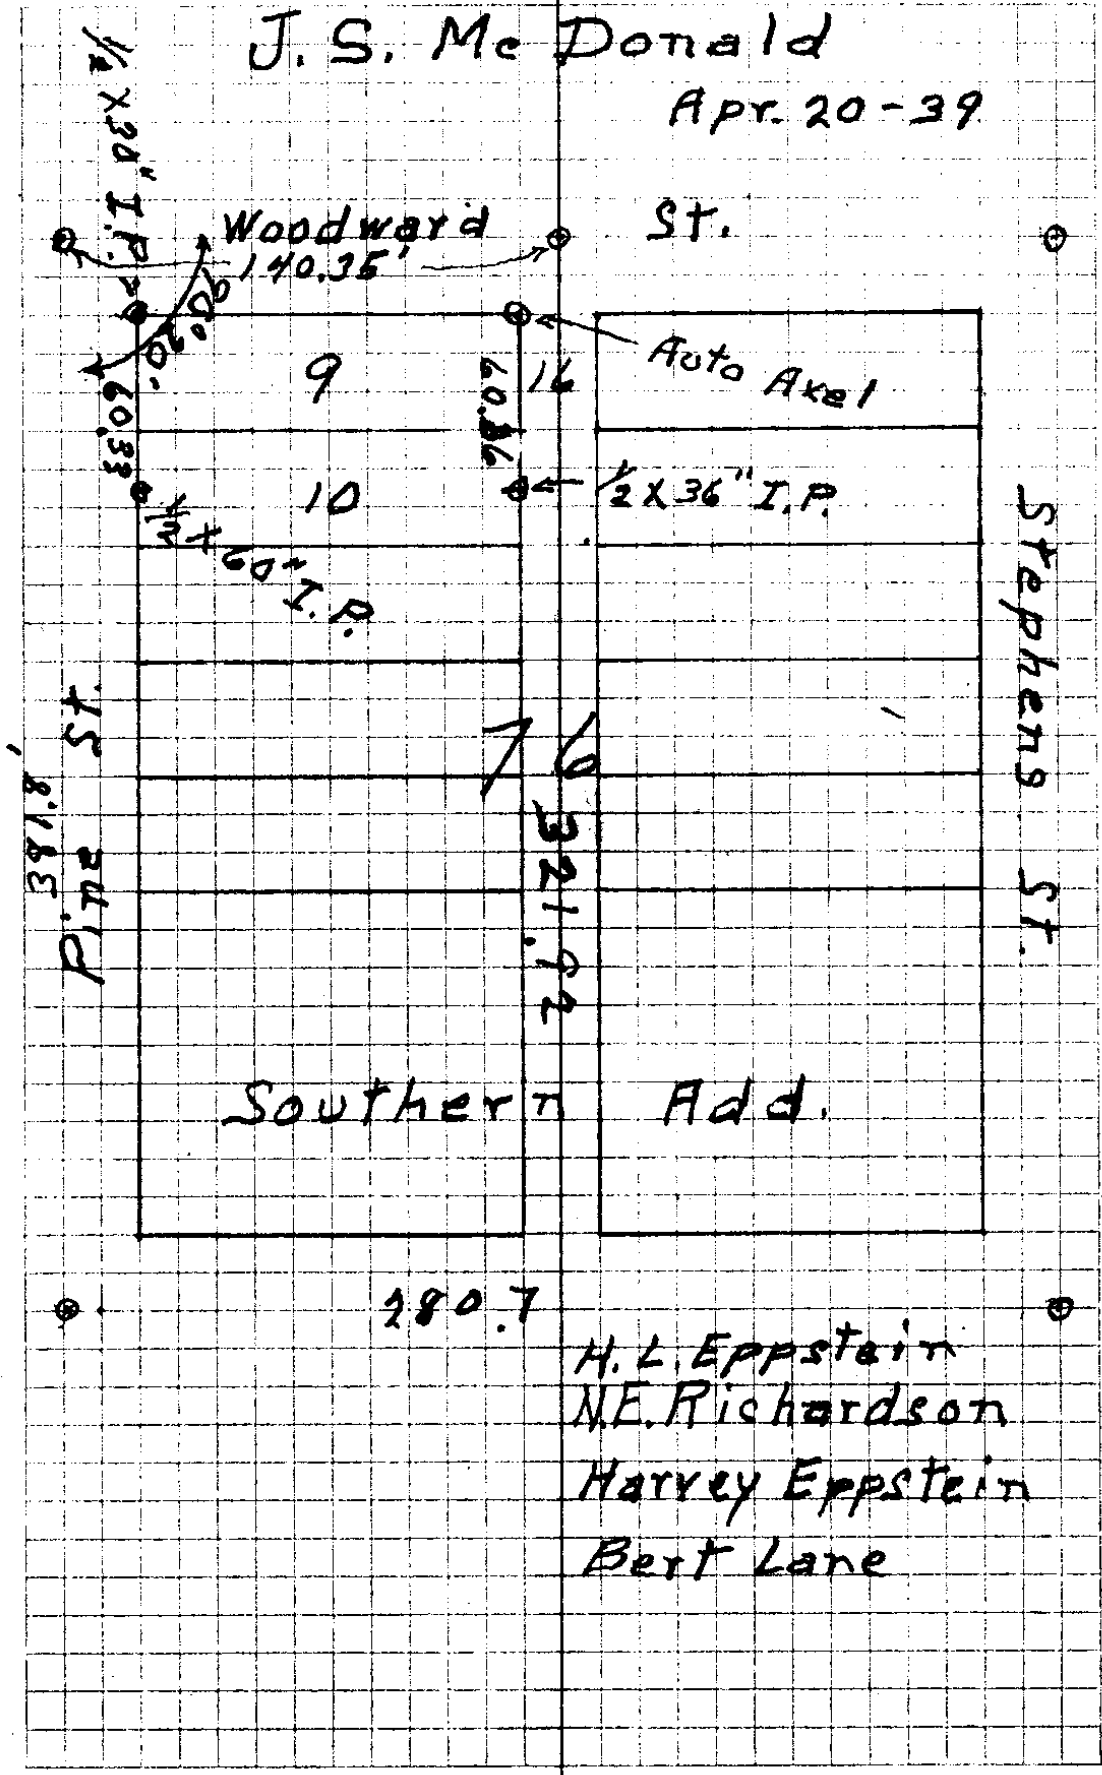

- H. L. Eppstein
- N.E. Richardson
- Harvey Eppstein
- Bert Lane