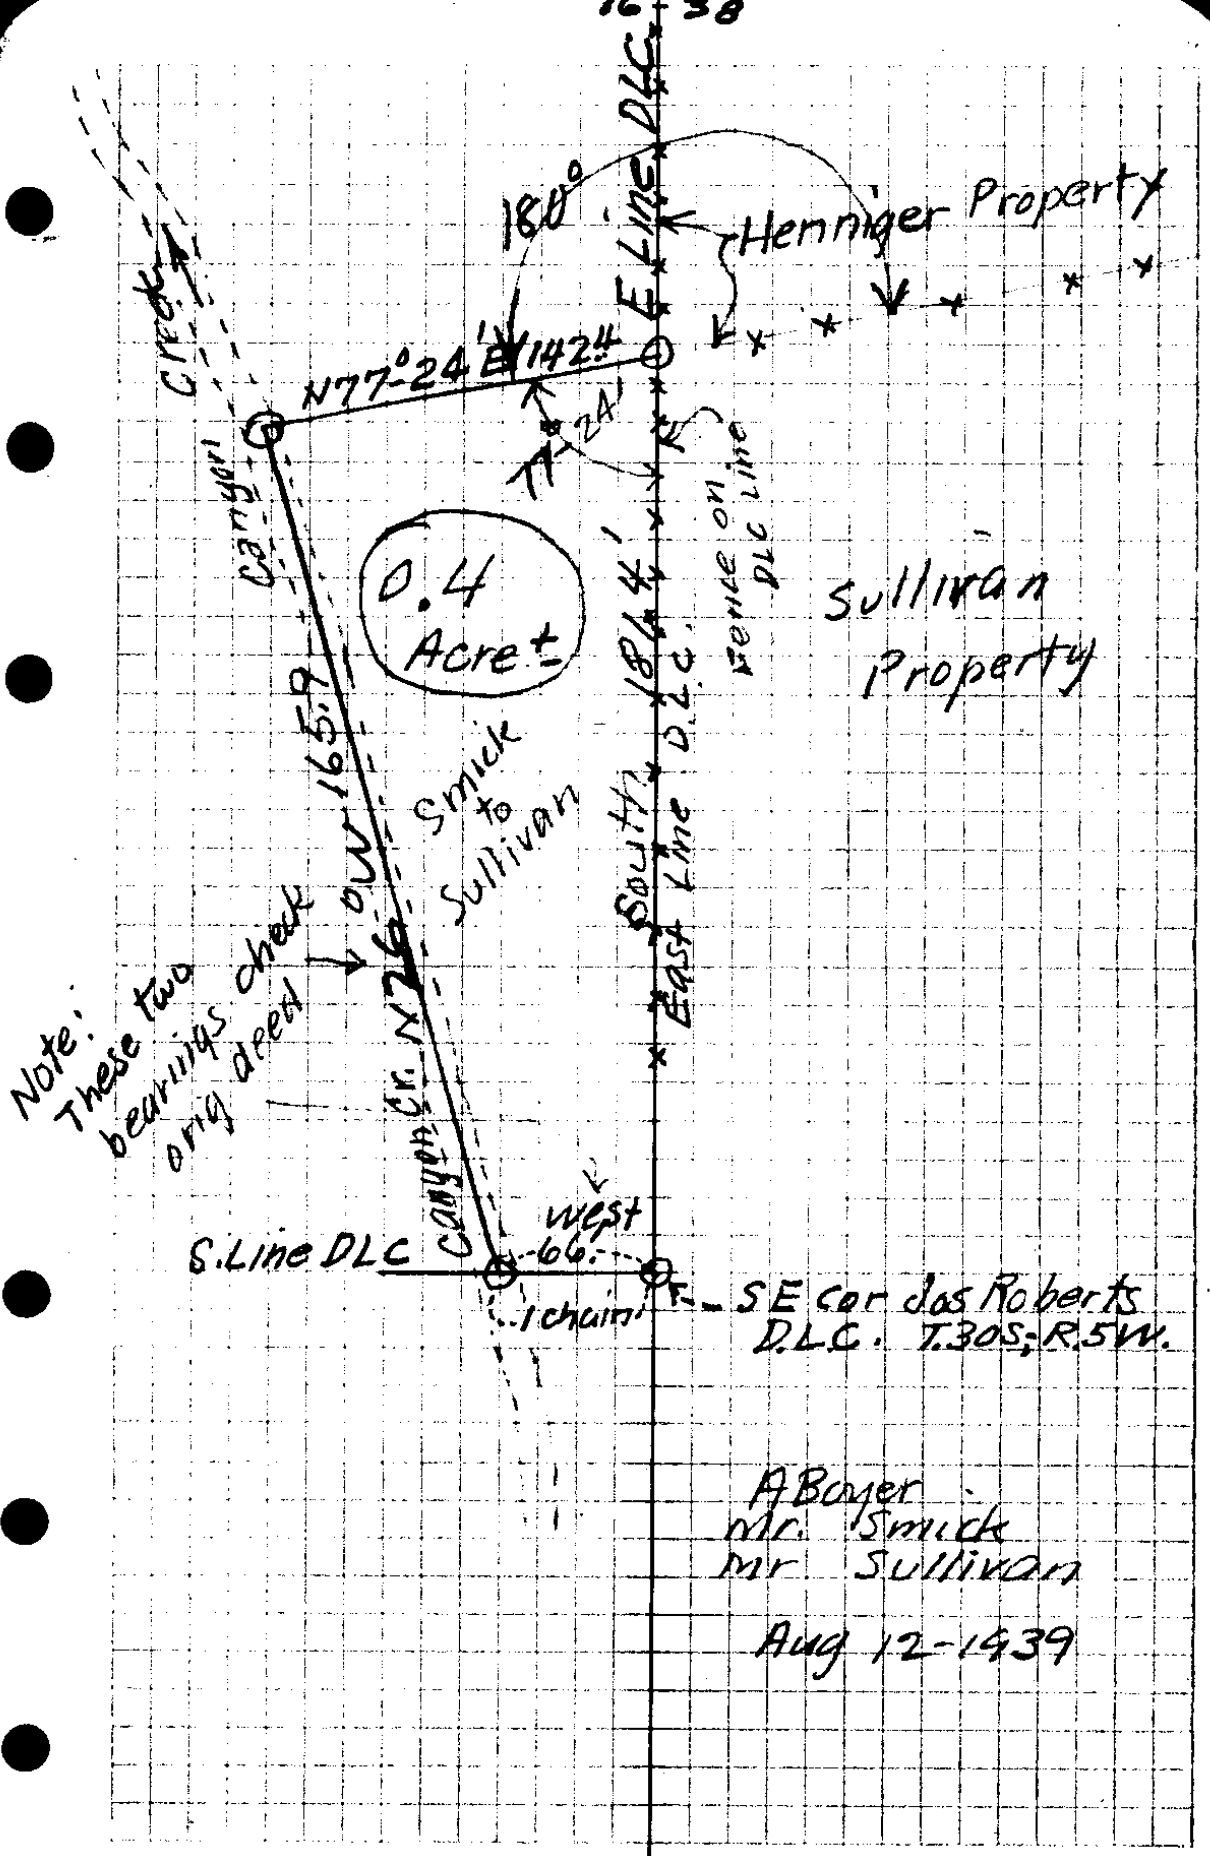
16 38
E Line DLC
180°
Henniger Property
N77°24' E 142.4'
24'
Canyon Cr.
0.4 Acre ±
Sullivan Property
Fence on DLC Line
South 184.4' East Line D.L.C.
Smick to Sullivan
Note: These two bearings check orig deed
S. Line DLC
Canyon Cr.
West 66'
1 chain
SE cor das Roberts D.L.C. T.30S; R.5W.
A Boyer
Mr. Smick
Mr Sullivan
Aug 12-1939