LOT 1 + S½ LOT 2 SURVEY FOR Sept 11-39

Railroad Add. 16-41

Ore Turkey Growers Assn

Jas. E Conn

Roseburg

Sept 11-39 Boyer HLE Jr.

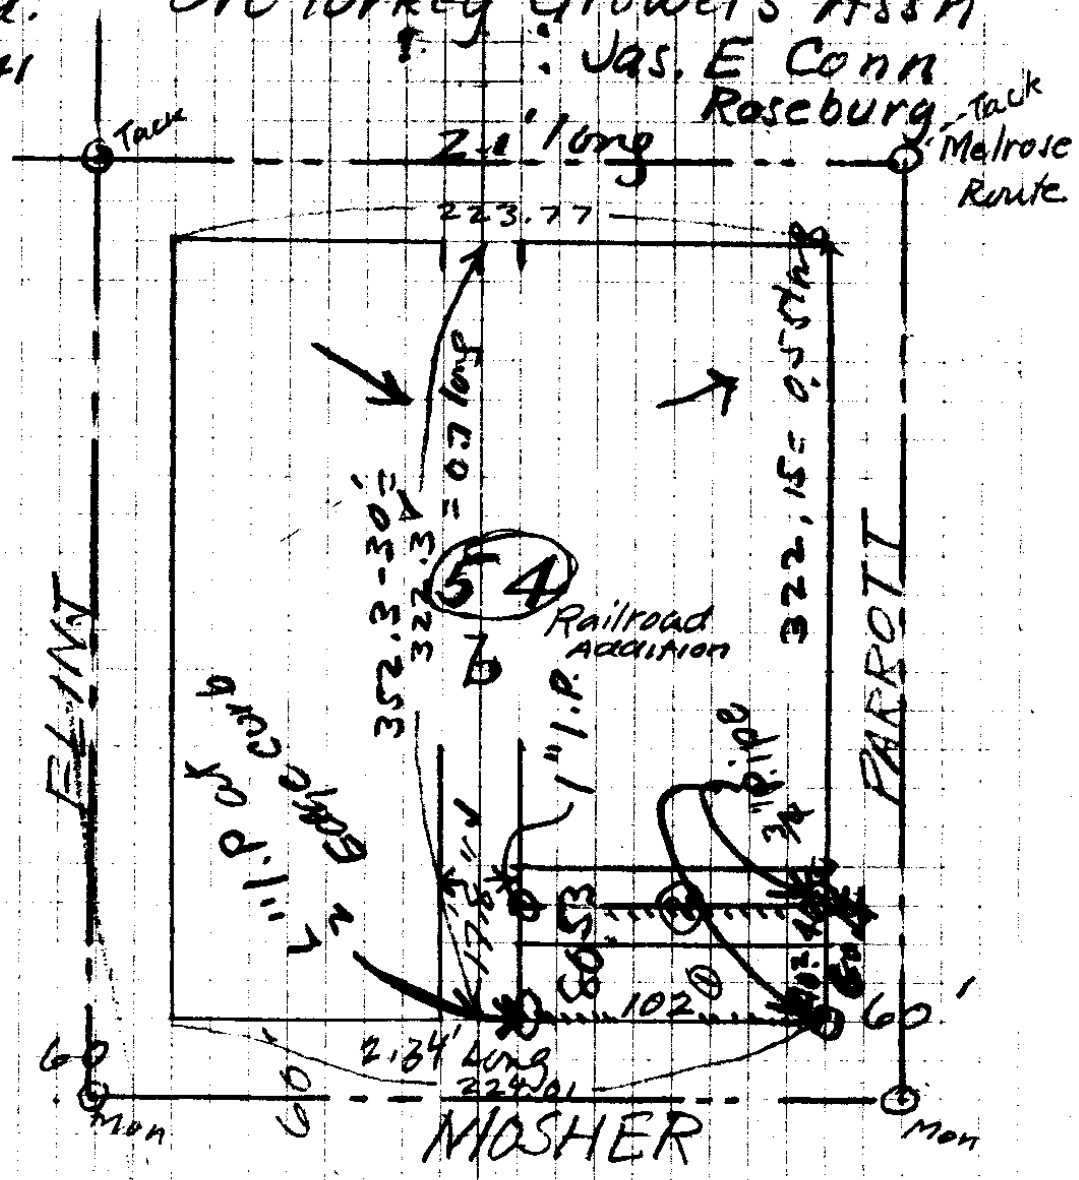

2|17.7
6
8.85
102
30
140.8

40.2
8
321.6
322.3
321.6
.7

8|.7
.09
.04
.13

80
30
110.4

40.2
201
60.3
30
90.3

2|2.34
4.17

102
102
17.67
2.34
224.01

102
102
17.67
2.4
223.77

60.3
1
60.4

322.15
321.6
8|.55
.07

60.3
60.43

S. File No. 16|4