


J.W. Doyle & Margaret H. Doyle

J.D. Myers & Arlene Myers  
197/403

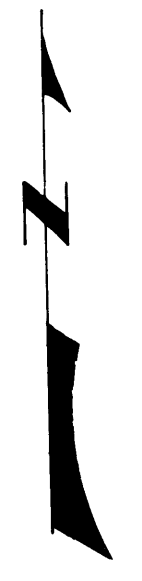

DOUGLAS COUNTY ROAD DEPT.  
VICINITY MAP  
of  
INTERSECTION

GARDEN VALLEY ROAD & OLD PACIFIC HWY.

JANUARY 1961  
SCALE 1" = 20'

A. H. MAY COUNTY ENGINEER

Aug 18 1957

NE Cor 1/4" I.P. 30" lg.

set this

1215  
1303  
-----  
251.8

121.5  
103.3  
-----  
224.8

set 1" Gear  
Axle

GARDEN VALLEY RD  
GLV RD



MAF 3  
44  
FOUND  
1/2" PIPE

107  
130.3

114-12

524-16'E

275.7

PACTHY

1/4" bar  
18" lg

S. L. CO  
H. O. I.

1" Axle  
Gear  
313/144

OLD FENCE  
OK  
106

24.6  
used  
this

Survey for Hancock

OIL CO -  
{ EPSTEIN  
{ BOYER  
{ RICHARDSON

1021  
350  
-----  
106  
246  
-----  
175.6

106  
32  
-----  
138  
306  
-----  
7.4

OVER -

beg 121.5' W of ~~rd~~ Co D L C 56  
th S along W line Co Rd  $23^{\circ} 10' E 307'$   
to E line D L C. - th S 55'  
th W 1060' th N  $23^{\circ} 10' W 356'$   
th E 1033'

Comm at pr wh E line D L C 56  
intersect W line Co Rd  
th S along W line Co Rd 75'  
th W 32' to E line D L C 56  
th N. along E line D L C 56  $59^{\circ} 10''$   
to beg