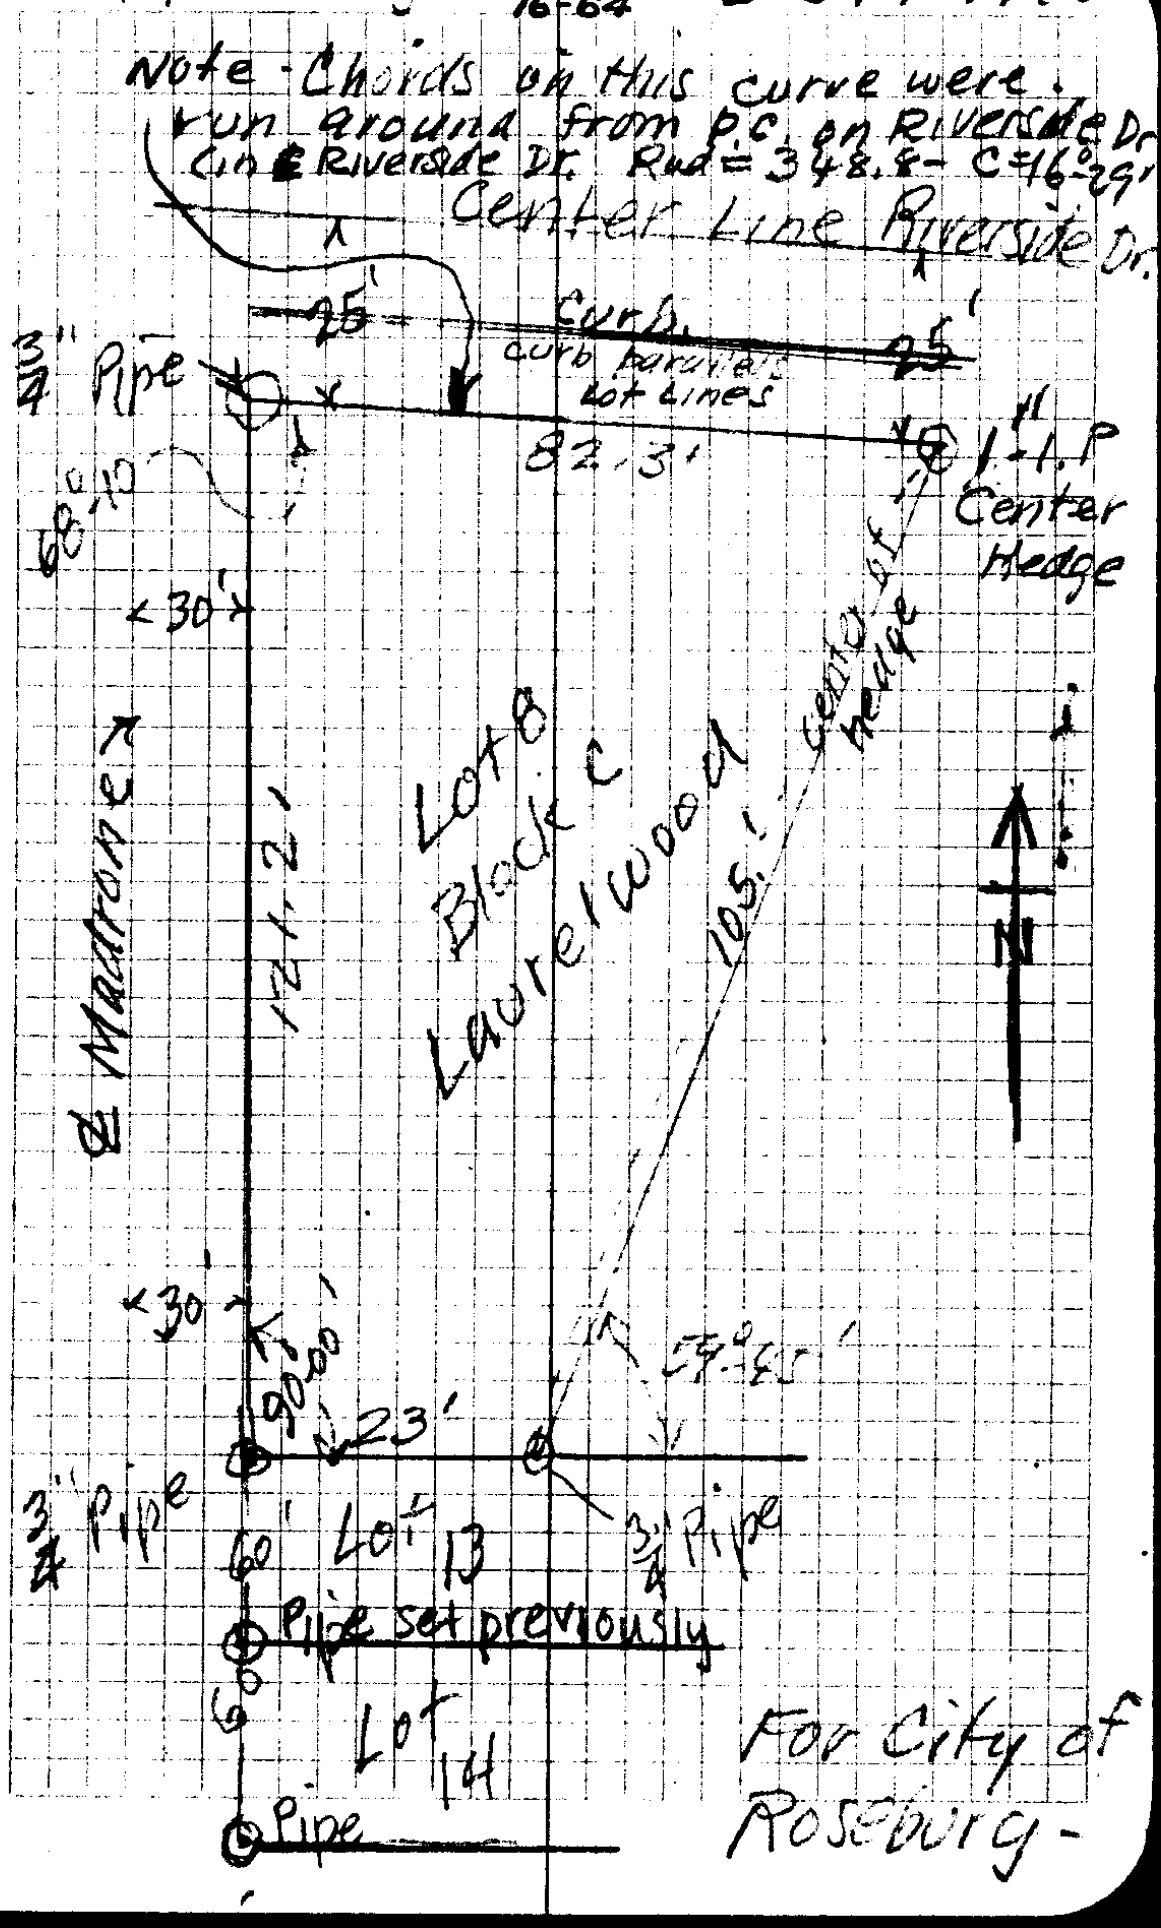Boyer, Sheila Kinger Weber 3-5+7-1940
16-64