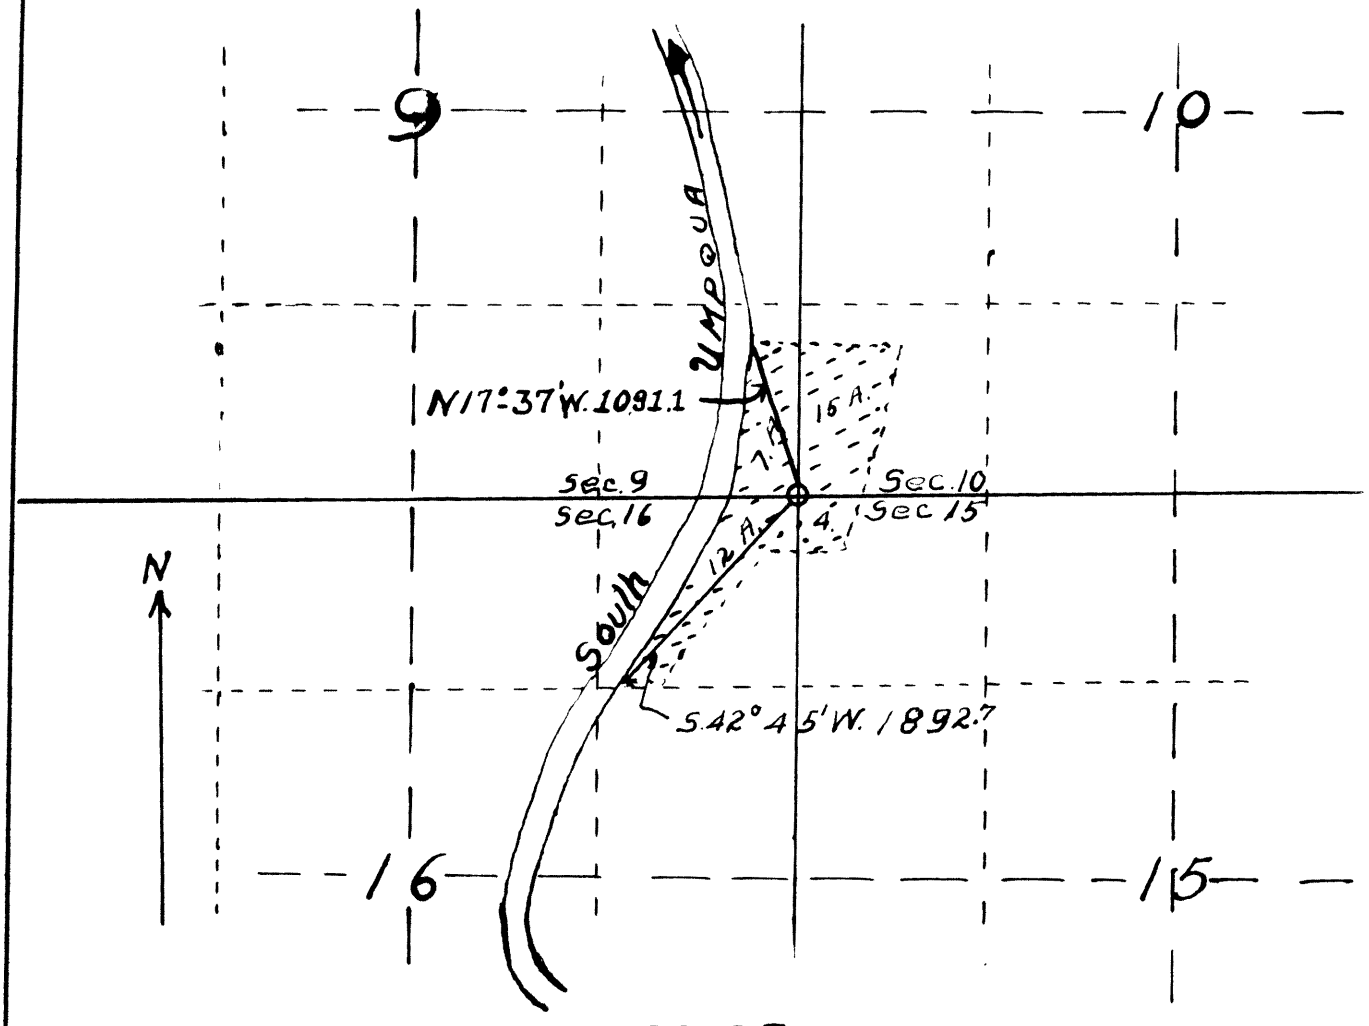

MAP OF

BEN F. JONES IRRIGATION SYSTEM

Sec. 9-10-15-16 T27S R.6 W.

Douglas County Oregon

H.L. Eppstein County Surveyor

CERTIFICATE OF Surveyor

I H.L. Eppstein of Roseburg Oregon do hereby certify that this map was made from notes taken during an actual survey made under my immediate supervision on Aug. 1920, and that it correctly represents the work described in the accompaning application with the location of streams and ditches in the immediate vicinity.

H. L. Eppstein

Oregon No 1011
Date of Registration
Nov. 8, 1920.