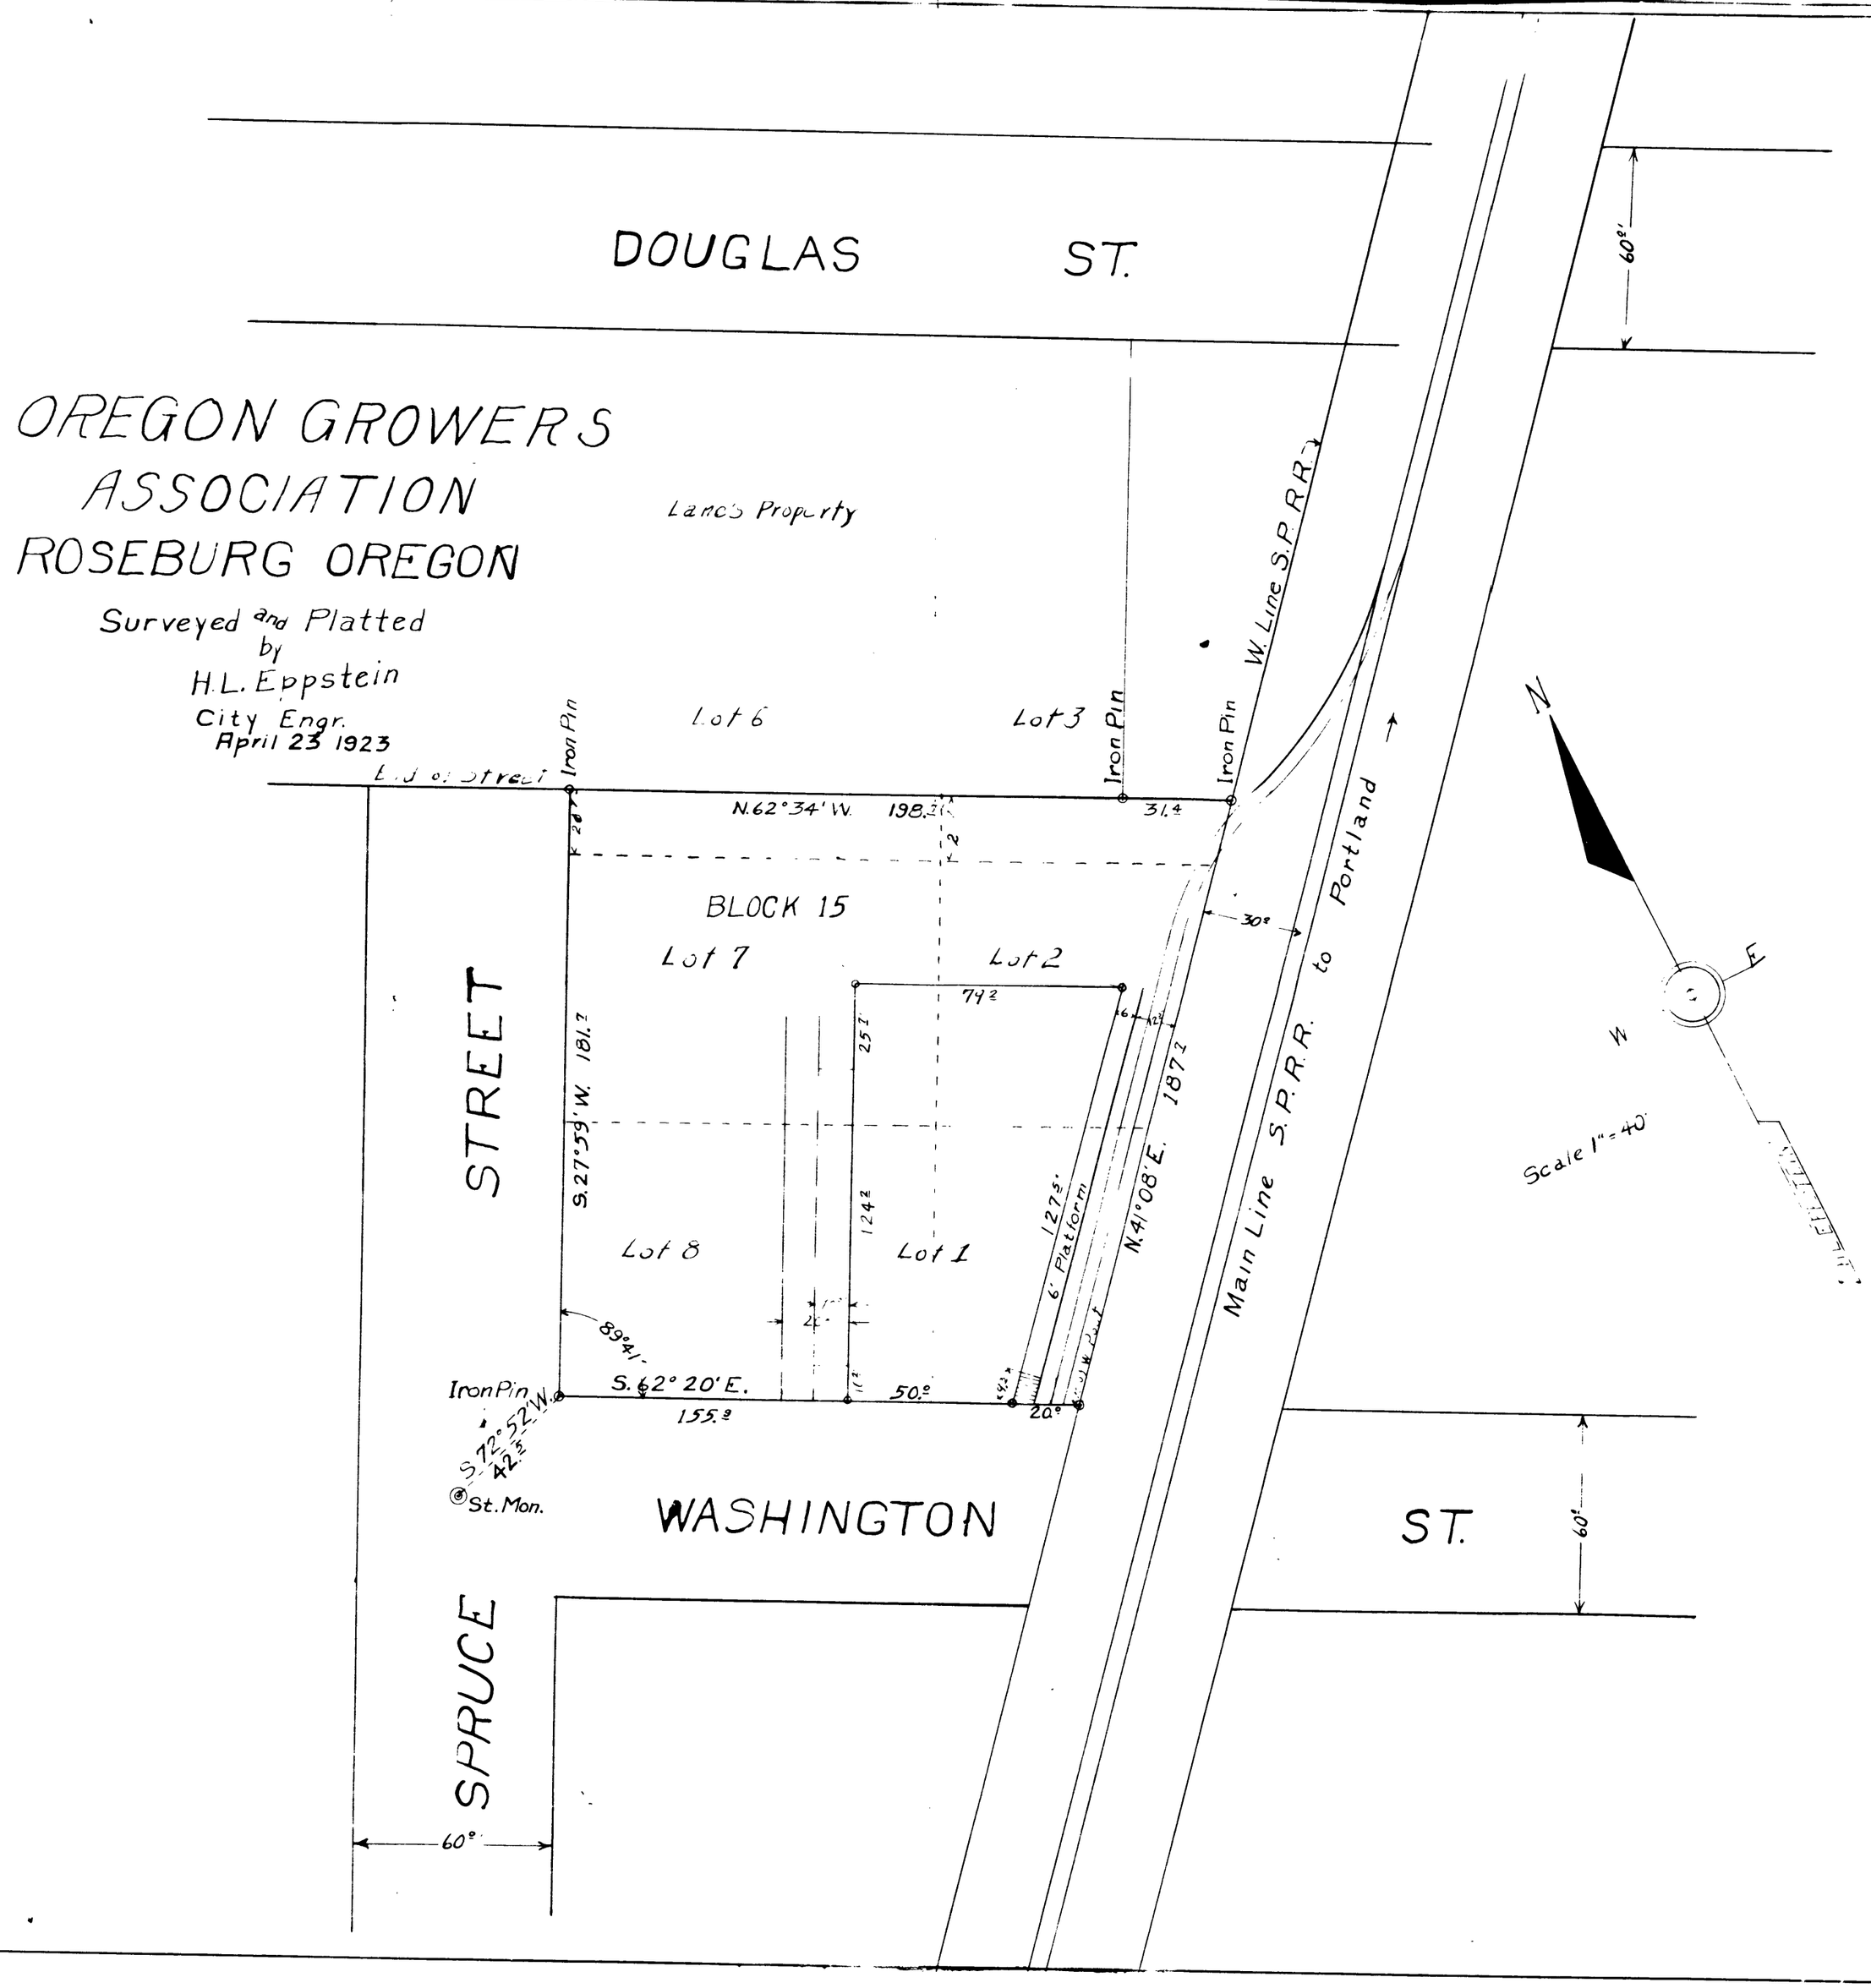
OREGON GROWERS
ASSOCIATION
ROSEBURG OREGON
Surveyed and Platted
by
H.L. Eppstein
City Engr.
April 23 1923
DOUGLAS ST.
60'
Lane's Property
Lot 6
Lot 3
Iron Pin
Iron Pin
W. Line S.P.R.R.
End of Street
N.62°34'W. 198.3
31.4
BLOCK 15
Lot 7
Lot 2
74
30°
Portland to Main Line S.P.R.R.
STREET
S.27°59'W. 181.7
25
124
Lot 8
Lot 1
127.5
6' Platform
N.41°08'E. 187
89°41'
S.62°20'E.
155.3
50.0
20°
Iron Pin
S.72°52'W.
42.5
St. Mon.
WASHINGTON
ST.
60'
SPRUCE
60'
N
E
W
Scale 1" = 40'