

Time VA HA

257 51° 10 1/2

301 10 50° 29 1/2

{ 304 41 49° 50 1/4

{ 305 47 49° 38

{ 306 36 49° 29 1/2

{ 307 31 49° 20

---

	H	R
3.11		
N	76° 13	47° 44 1/2 <del>10</del>
R	75° 52 1/2	47° 30 <del>10</del>

---

R	76° 13	47° 34 <del>10</del>
	76° 51' 15	47° 28
N	77° 29 1/2	47° 42



# N. W. Cardwell

Cor 38 SW

		18°	42°	S55°2'E	S55°30'E
1	35°04' L	7 1/2'	140°	East	N89°26'E
2	Road				
		4d	160°		
	4°37' R	13°	300°	S86°E	S85°57'E
		-	70°		
3	3°55' R	-	219°	S82°E	S82°02'E
4	30°08' L	-	165°	N67°50'E	N67°50'E
5	29°38' R	-	203°	S82°E	S82°32'E
6	5°49' R	-	699°	S76°35'E	S76°43'E
7	20°14' L		405°	N83°E	N83°03'E
8	63°34' L	14°	117°	N19°E	N19°29'E
Cor.	74°22' L	6°	149°	N55°W	N54°53'W
9	24°13' R	2°	217°		N30°40'W
10					

40<sup>2</sup>

127<sup>8</sup>

29232  
703

113<sup>6</sup>

148<sup>8</sup>

217<sup>4</sup>

530  
384  
903  
445  

---

2222

17964  
9403  

---

8557

55930  
3504  

---

17964  
903

1489  
77  
94  

---

1685

200  
20  
72  
12  

---

67

29  
17  
47  

---

32

76  
20  

---

46

1483  
63  
96  

---

119

545  
21  

---

3040

10					N 30° 40' W
	60° 0' L	-	8°	west	S 89° 20' W
Cor	Tie				
	67° 26' L	-	230 <sup>4</sup>	S 81° 30' W	S 81° 54' W
11	4° 01' R	3°	164 <sup>3</sup>	S 85° W	S 85° 55' W
12	11° 18' R	8 1/2	193 <sup>7</sup>	N 83° W	N 82° 47' W
13	7° 24' L	6 1/2	158 <sup>2</sup>		S 89° 49' W
14	6° 30' R	3 1/4	240 <sup>6</sup>	S 83° 10' W	S 83° 19' W
15	15° 43	7°	253 <sup>5</sup>	N 81° W	N 80° 58' W
16	By back	west side			
	8° 16' L		159 <sup>10</sup>	N 89° W	N 89° 14' W
17	0° 20' R	-	300 <sup>30</sup>		N 88° 54' W
18	By fence				
	10° 43' R	24 3/4	103 <sup>8</sup>	N 87° 20' W	N 87° 11' W
19	16° 35' R	28°	128 <sup>0</sup>	N 70° 20' W	N 70° 36' W
20	12° 03' R	27 1/4	154 <sup>2</sup>		S 89° 28' W
Cor					

30 10  
 67 22  


---

 17 4 60  
 9 8 66  


---

 8 1 54  
 4 0 1  


---

 8 5 55  
 11 18  


---

 17 9 60  
 9 7 13  


---

 8 2 4  
 7 2  


---

 17 6 10  
 9 0  


---

 8 9 49  
 6 30  


---

 8 2 14  
 15 43  


---

 17 4 60  
 9 4 0  


---

 8 5  
 19  


---

 8 7  
 16 35  


---

 7 0 3  
 1 3 08  


---

 5 8 2

140<sup>2</sup>

191<sup>6</sup>

157<sup>9</sup>

140<sup>4</sup>

253<sup>4</sup>

93<sup>6</sup>

113<sup>0</sup>

141<sup>8</sup>

Cl. Cor

1

-

300<sup>↓</sup>

S1°E

S1°25'E

71<sup>↓</sup>

600<sup>°</sup>

300

300

300

300

2°29' L

S1°10' W

S1°04' W

2

8°58' R

111<sup>6</sup>

S10°10' W

S10°02' W

3

13°32' W

-

206<sup>5</sup>

S3°25' E

S3°30' E

4

1/4 Cor

333<sup>°</sup>

west

7<sup>1/2</sup>

114<sup>°</sup>

113<sup>1</sup>

11<sup>°</sup>

191<sup>8</sup>

188<sup>5</sup>

7<sup>°</sup>

300<sup>°</sup>

297<sup>7</sup>

-

67<sup>°</sup>

67<sup>°</sup>

999<sup>3</sup>

10<sup>°</sup>

113<sup>3</sup>

111<sup>8</sup>

20<sup>°</sup>

202


189<sup>8</sup>

1380<sup>9</sup>

75° 29  
52° 30

297  
218.5

74° 56  
51° 45  
52° 07  
63° 53

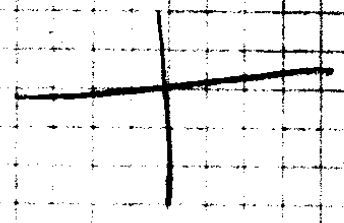

87° 53  
66° 34  
46 59

$425 = 75^\circ 43' 16''$

2151 26  
75 43  
66 34  
9 08

sin 75° 43' 16"  
sin 9° 08' 45"

9.98637  
9.70125

sin 46° 57 9.86101  
sin 37° 53 9.78821

.13599

21179  
19.55540  
9.76770

540 59  
108 17 30  
431 42 30  
75 12 30  
356 30 00

54° 08' 45"  
108° 17' 30"

N N 3° 30' W  
Course 3 to 4

1/2 COR

5°  
+ 1/2

99°  
2855

N 1° 05' E S 1° 01' W

1

17° 21' L

-

300

N 18° 26' E S 18° 22' W

2

27° 09' R

123°  
226°

S 8° 1/2' E S 8° 47' E

3 = #4

5° 17' L

S 3° 30' E

4 = #3

17-39 00 S/W


JUNE 3  
9 30 AM

B. Sun N 61° E

V. 50° 35' W



H. 9 113° 55' W  
N 5° W

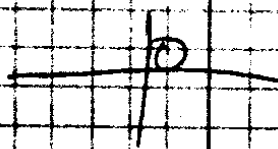

V. 51° 00' W  
113° 28' W  
56° 01' 09' W

Ray 39<sup>18</sup> ch E + 9<sup>11</sup> d.S.  
y SW cor. sec 16 T 286  
th S671<sup>0</sup> To get on Mark  
at y way C. B. by

CS FILE FOLDER

CONTAINS

MORE

INFORMATION