


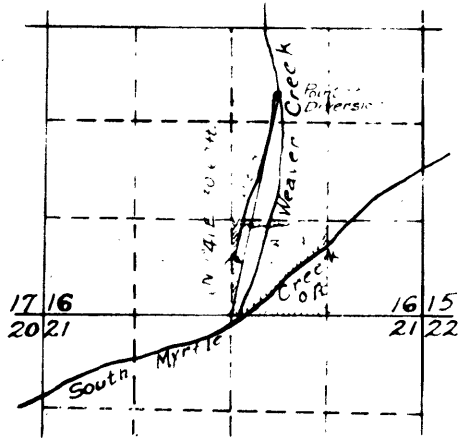

Scale 2 in = 1 mile.



MAP OF E. M. MARSTERS IRRIGATION SYSTEM

SEC. 16 T 29 S R 3 W. William. Mer.

Office of H.L. Eppstein Co. Surveyor

Oct. 25, 1927

CERTIFICATE OF REGISTERED PROFESSIONAL ENGINEER

I H.L. EPPSTEIN, of Roseburg, Oregon, do hereby certify that the map was made from notes, taken during an actual survey under my personal supervision, on Oct. 23, 1927, and that the work described in the accompanying application, together with the location of streams and other ditches in the immediate vicinity.

H.L. Eppstein
Registered Professional Eng.

Oregon License No. 101

Date of Registration Nov 8, 1927.

C.S. 17/19B6