

19/18A

Sta Dist Left Right MC

9

1218
45.22'

8

1350
10.00'

7

2708
23.000'

6

141

Top Ridge

5

1388
41.55'

4

8258



3

1642
19.90'
1562
20.00'
1551
1475
3026

2

173

1

1532
29.35
253
1331
253
158


∇

East

1/4 car bet 1-2

Run in East

Est Im Draw

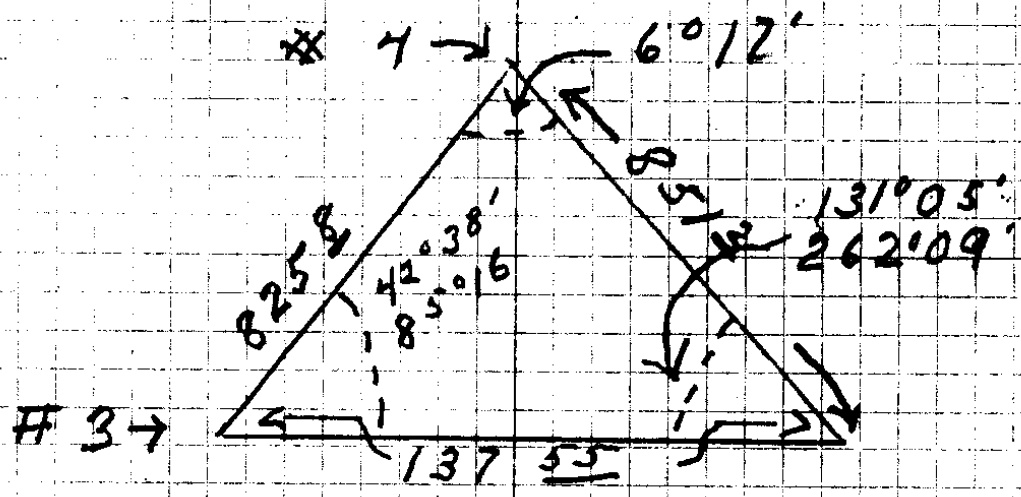

19/HA

10

9

—

Harry Henderson T. 21 S. R. 11 W.

April

1938

68/191

Renew of Corners

1/4 Bet. Sec. 1-2 T21S R11W

Found Old Stake Marked

1/4 C.S. Set steering gear of Auto

Old STump Practically All

decayed distance check

Original 10" cedar to
Bradley burned to read
scribe MARKS, distance & bearing
check. Remark 1/4 S. C. S. B. T.

Cedar Now 30 S43°E 26 Feet

Alder 8" Dia. S28°W 17 1/2 Feet


Marked 1/4 S C S B T

APRIL 14-38

B F Lane

H H Henderson

J B Abbott

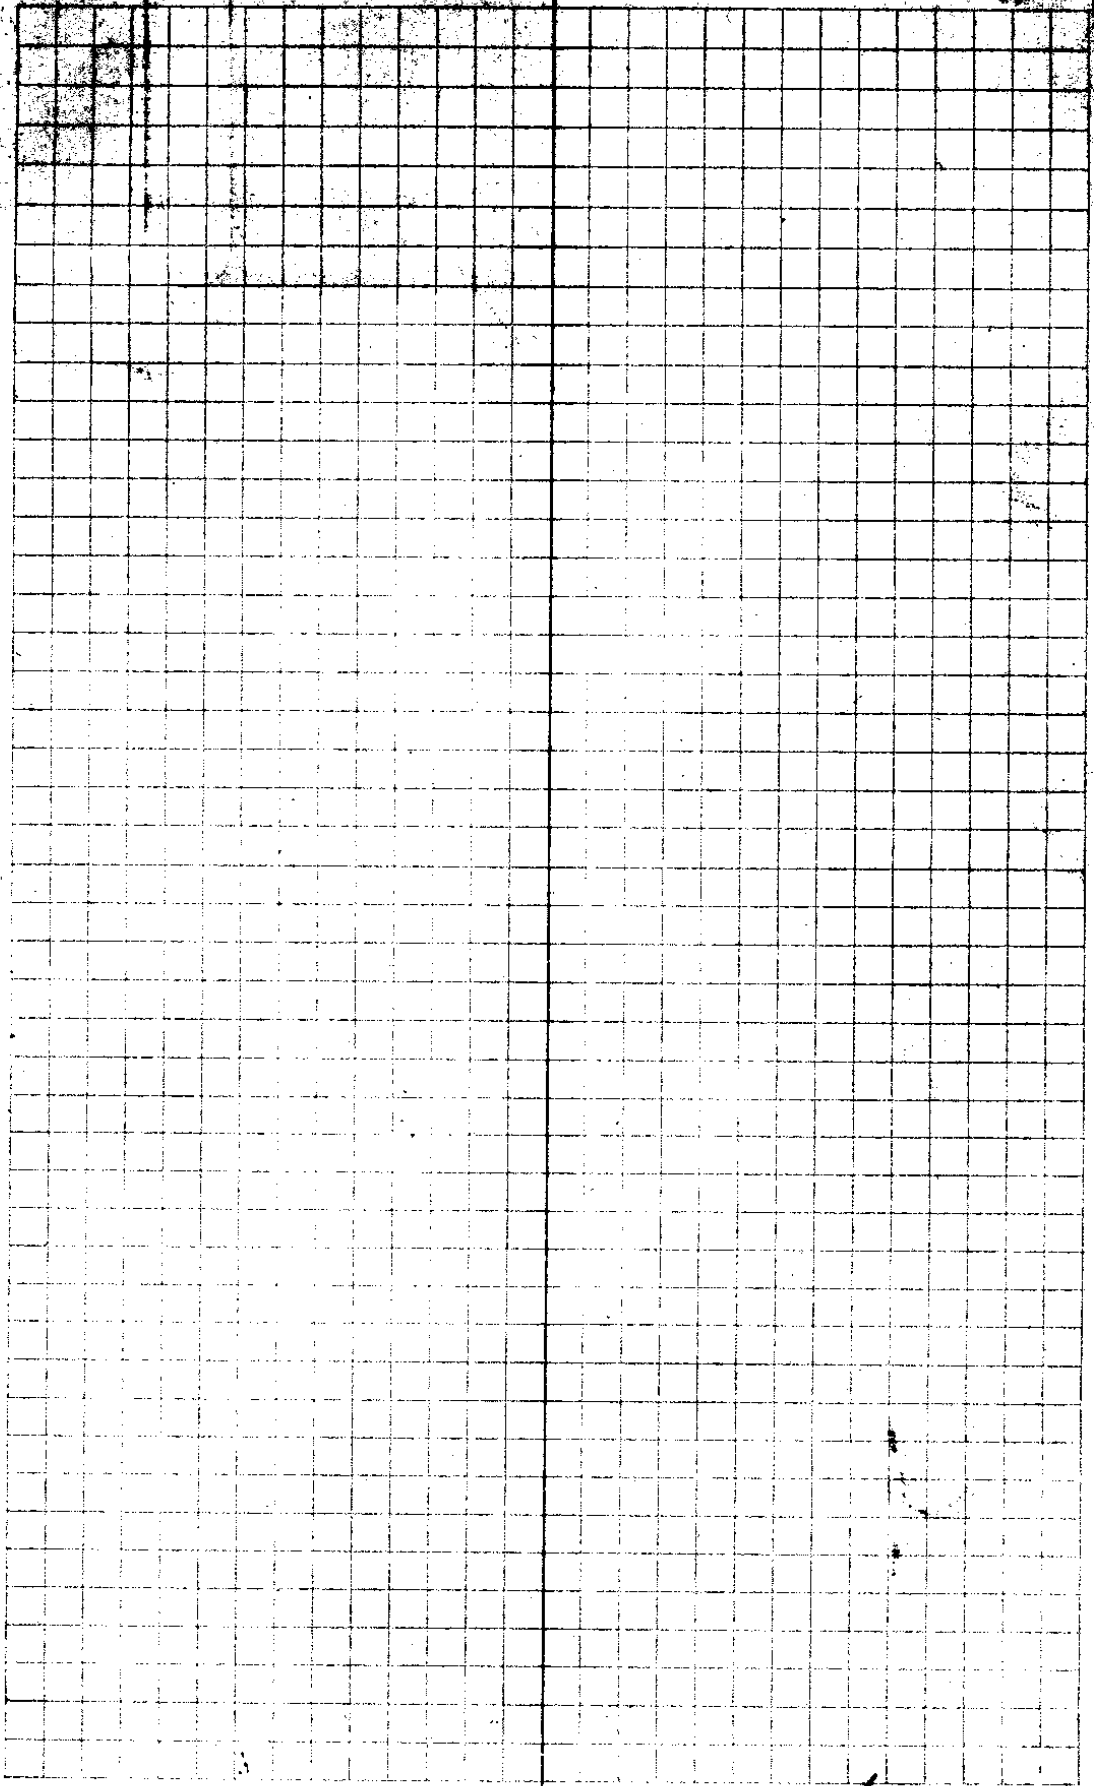

19/150

Sta Dist Left Right M.C. C.C.

10

292

9

1050
4200 780

8

900
4100 590

7

1490
830 1470

6

1000
3000 990

5

80

4

975
3800 760

3

150

2

640
2100 620
2300
2400 1870

1

Running East



SEC CIV

1-2-11-12

#

2802
—
2420

19/15A

Sta

Dist

Left

Right

MG

CC

6

2750
16.00

2643

5

2200
29.00

1504

4

1190
32.00

910

3

1830
23.00

1670

2

2400
21.00

2222

1
Corr 1/16
1/4

104
20.00

977

← NORTH

285

→

13

3000
29.30

2964

12

2000
24.00

1682

11

1400
43.00

682

10

EAST

#

492.8

827-2 40 11


19/18A

Sta Dist Left Right MC.

8	1370 1260 1100		
7	1870		
6	620		
5	1110 900 1095		
4	380		
3	1320 1100 1290		
2	130		
1	300 320 250		
1/16 cor.	265		
7	600		
6			

North → ← East

IV

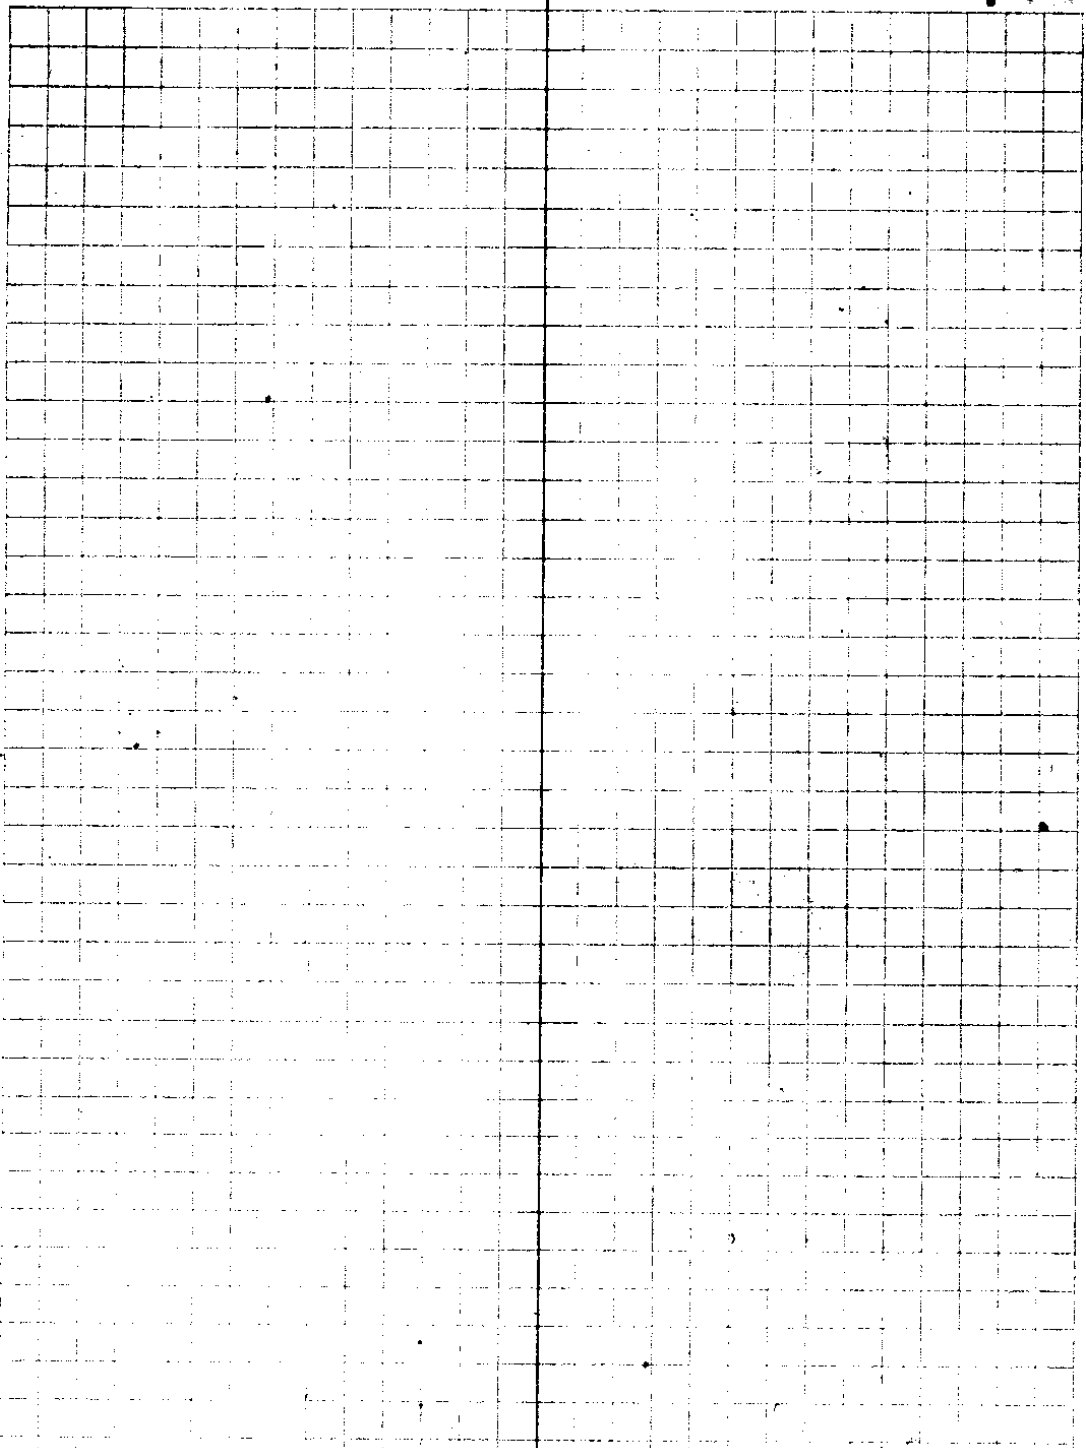

$$\begin{array}{r} 1320 \\ 994.9 \\ \hline 325.1 \end{array}$$



$$\begin{array}{r} 325.1 \\ 10 \\ \hline 265.1 \end{array}$$

19/1/84

Sta	Dist	Left	Right	MC.
5				
4	72			
3	<div style="border: 1px solid black; border-radius: 50%; padding: 2px; display: inline-block;"> 740 29.00 </div>			
2	<div style="border: 1px solid black; border-radius: 50%; padding: 2px; display: inline-block;"> 1000 30.00 </div>			
1	<div style="border: 1px solid black; border-radius: 50%; padding: 2px; display: inline-block;"> 203 17.00 </div>			
1/6 cor	640			
12	300			
11	<div style="border: 1px solid black; border-radius: 50%; padding: 2px; display: inline-block;"> 1150 29.00 </div>			
10	<div style="border: 1px solid black; border-radius: 50%; padding: 2px; display: inline-block;"> 1610 39.30 </div>			
9	1280			
8	290			



To #9 931.7

19/11/11

Sta Dist Left Right MG

1/16 cor

Sta	Dist	Left	Right	MG
13	917	1988 11-30		1254
12		698 4-00		662
11		300 26-00		269
10		165 42-30		1216
9				
8		1358 29-15		1178
7				
6	1040			10
5		1030 21-00		963



North



11

19/18A

Sta Dist Left Right M.C.

10				
9	700			
8	1200 40-00	1124		
7	1400 40-00	1072		
6	1912 42-00	671		
5	660 41-00	498		
4	640 34-00	530		
3	400			
2	940 33-00	788		
1	1000 40-00	535		
	1300 41-00	981		

1/16 COV

West
↓

~~11~~

The image shows a page of graph paper with a grid. A vertical line runs down the center of the page, and a horizontal line runs across the page near the top. The grid is mostly empty, with a few small dark spots. There are four hole punches on the left side of the page.

19/18A

Sta Dist Left Right M. C.

15

14

13

12

11


10

1400
15-30
1700
23-30
1452

180

1300
14-00
1262

VIII

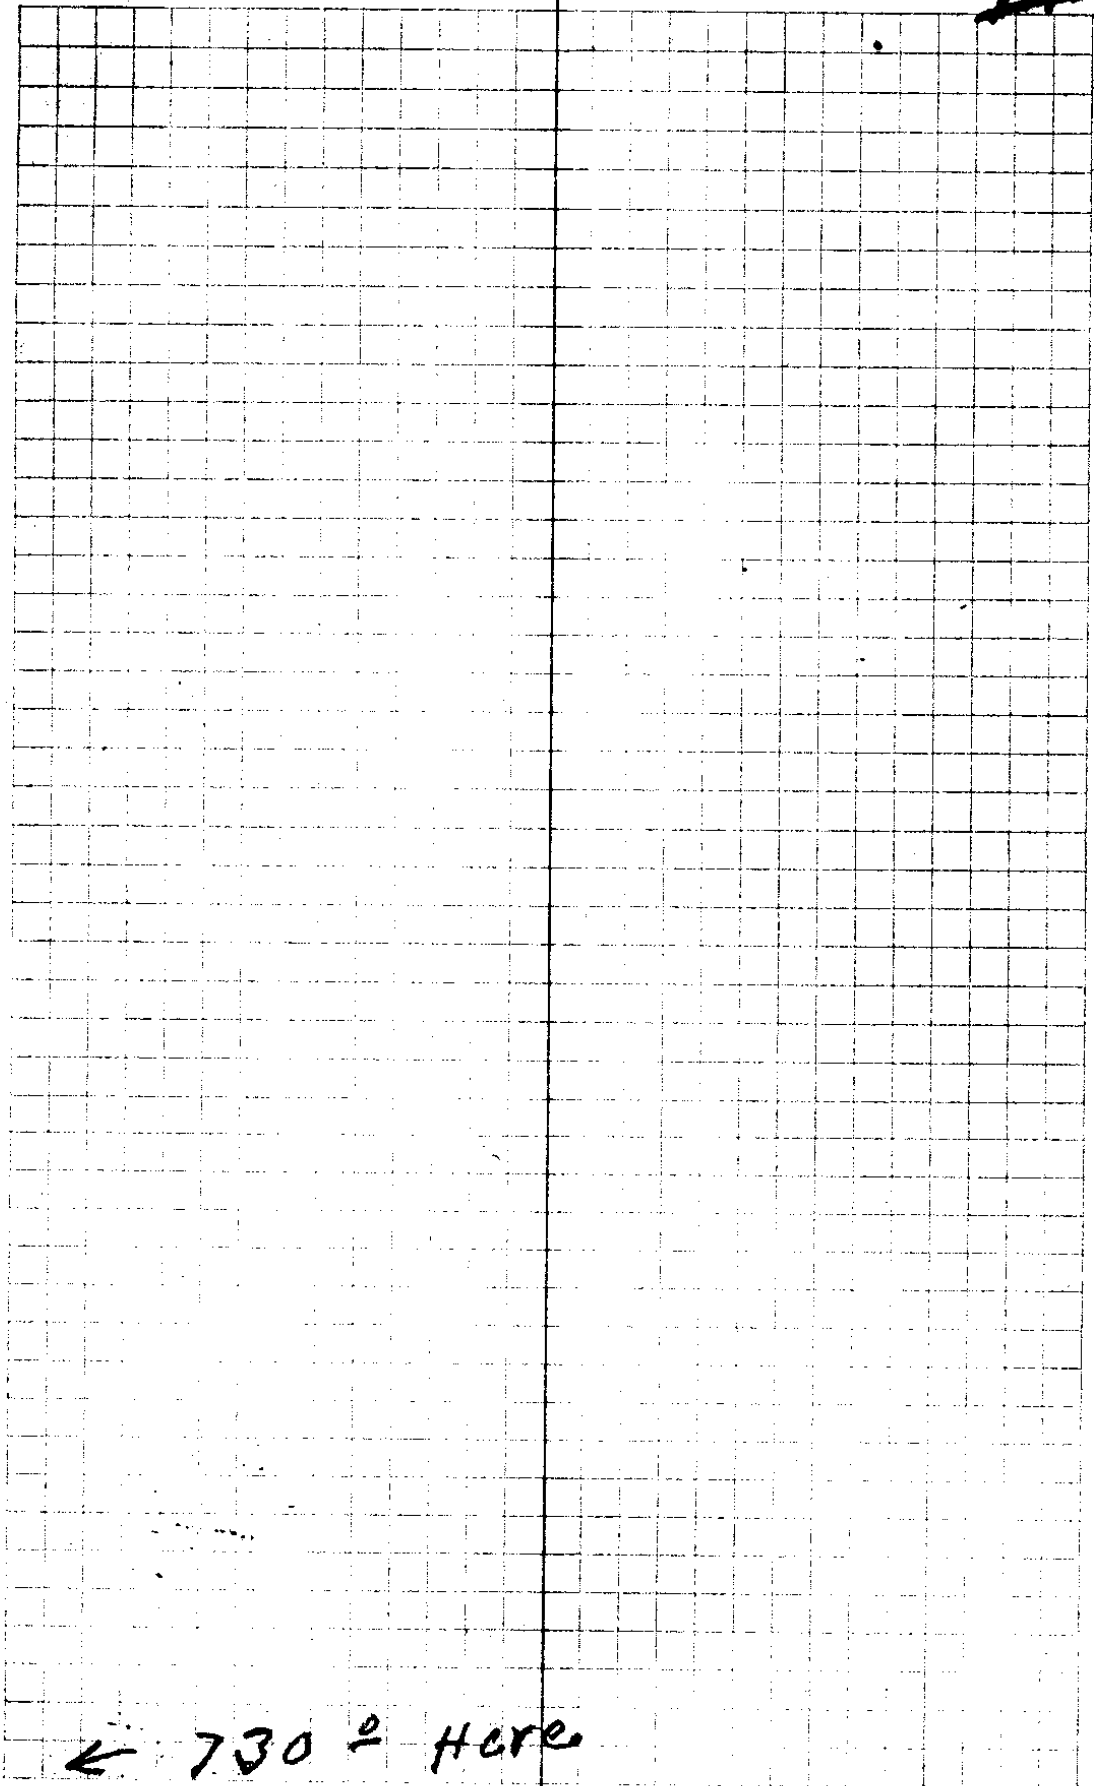

← 730 = Here

19/18A

← 730 to here

19/18A

