


MAP OF
 PROPOSED CITY DUMP GROUND
 Sec. 22 T 275 R 6 W. W.M.

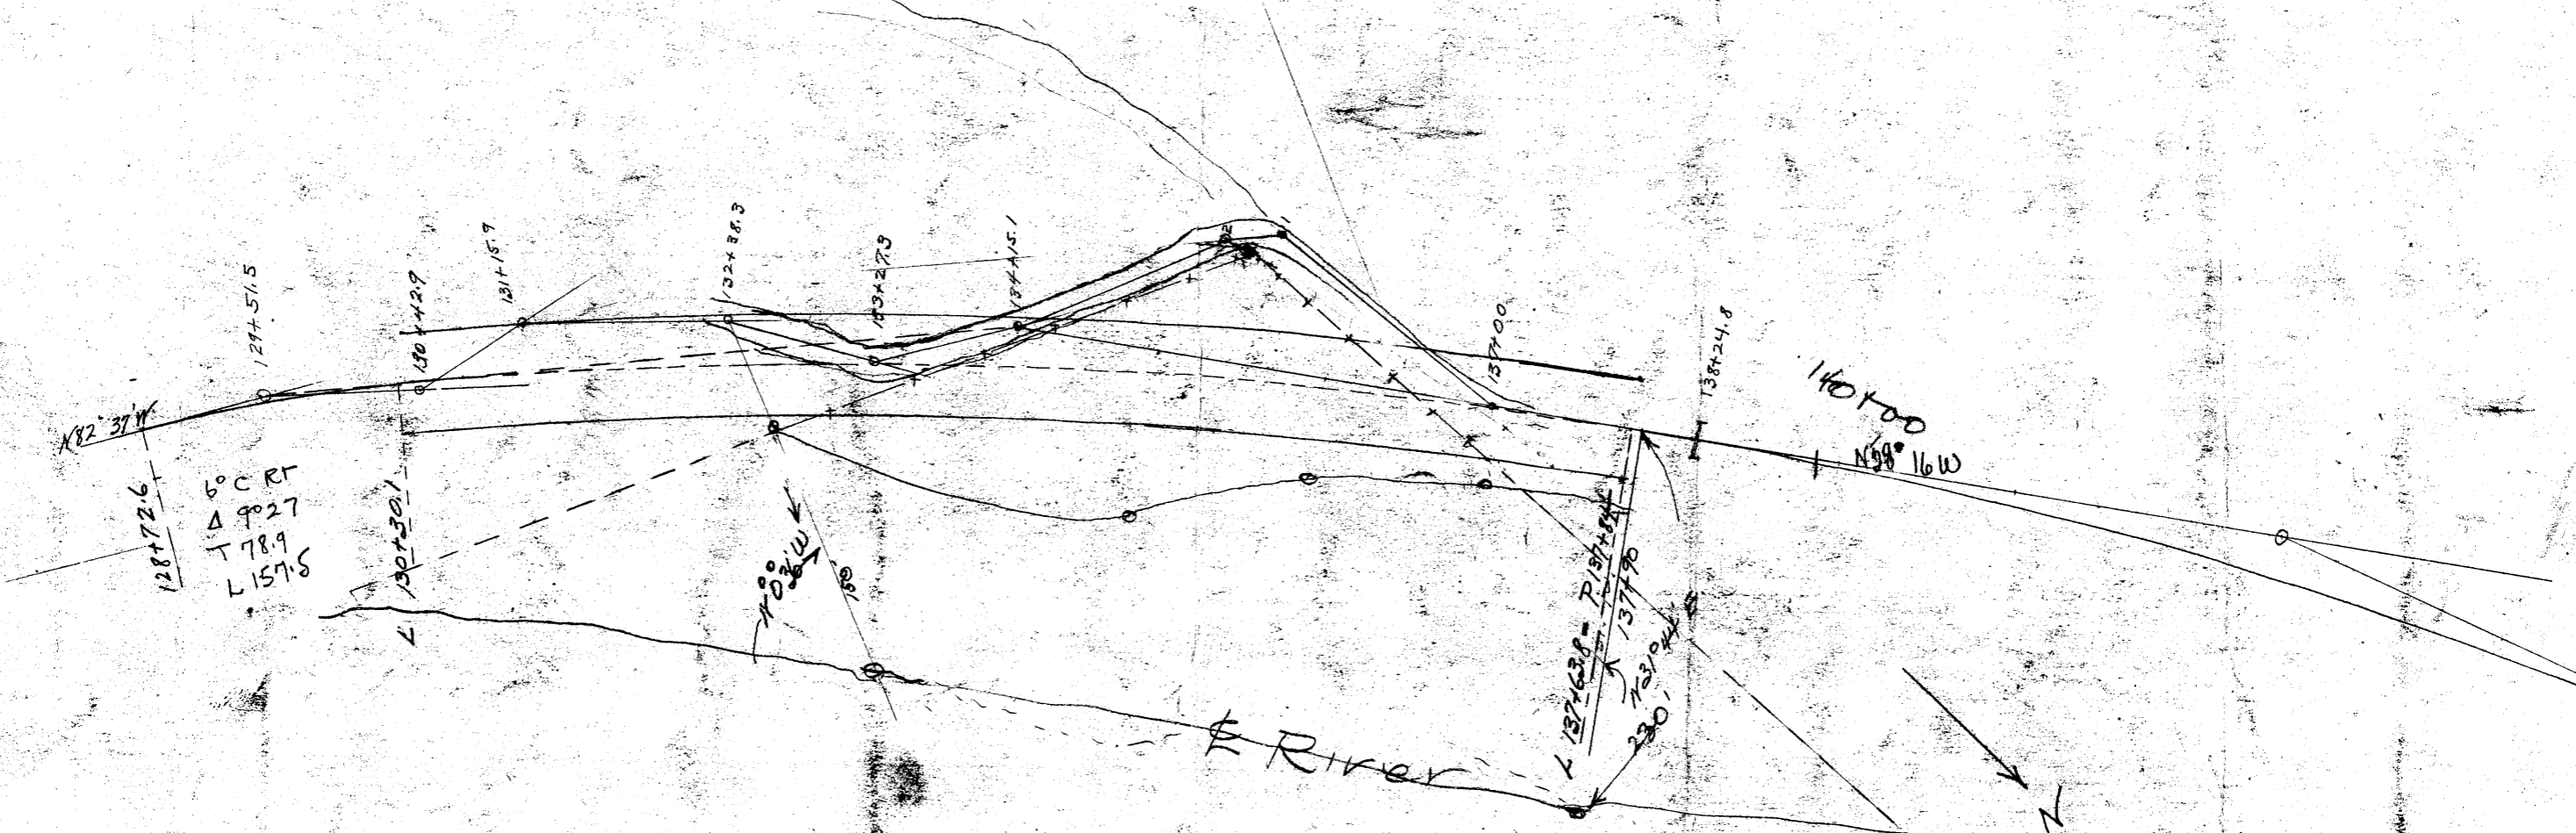

N82°37'W

128+72.6

6° CRT
 Δ 99.27
 T 78.9
 L 157.8

129+51.5

L 130+30.1

130+42.9

131+15.9

132+38.3

133+27.3

134+15.1

137+00

138+24.8

140+00

N98°16'W

N90°21'W

RIVER

2° 18' CRT
 Δ 140.54
 T 369.0
 L 733.7

L 137+63.8 - 137+00

137+90

138+24.8

2° CRT
 Δ 15° 23'
 T 387.0
 L 769.2


N

City Dump Grounds.

Sec. 22 T27S R6

Jan. 19-1929

Eppstein

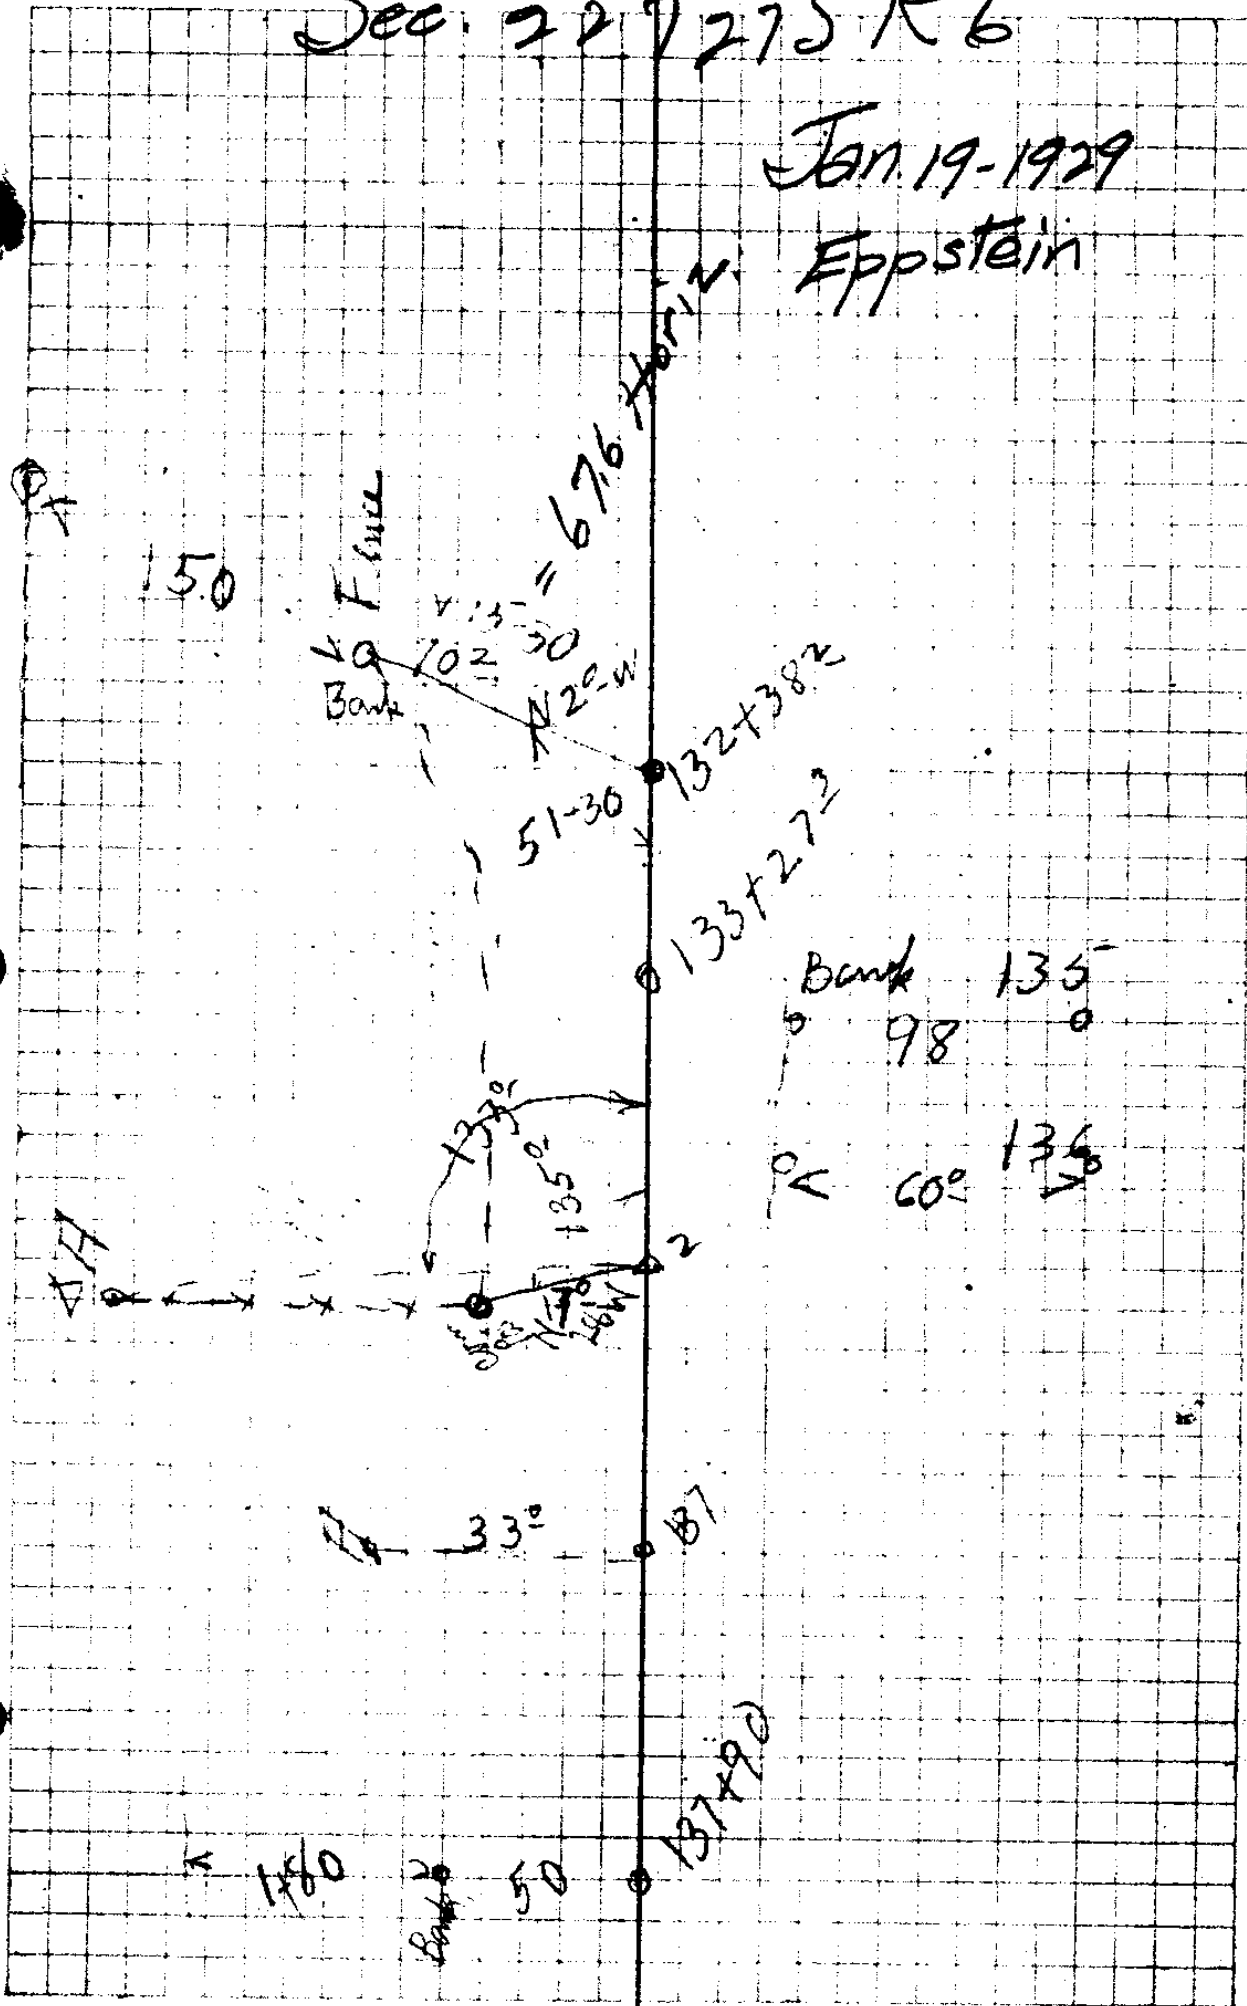

1929

Lft

Rt.

Draw gines
52.06

Draw gines
29° 39'

132+38^{0.1R}

F
133+27³

F
134+15²

Road 679

Δ 2

Δ 1

137

137+90

132

34[?]

161[?]

18-17

44°-12'

27-39

9°-07

29°-41

S55E

S87°-30E

N89-30E

S71E

S31E

N61E

S54-18E

S81°59E

N88°56'E

S72°47E

S28°35'E

S58°16E

W.T.
Sec 16

920
1930
67

POST

34-38

BC 151 + 77⁴

OR-TANGENT
176³ N 44-W



330'



140+00



230

9 staks



300

149+00



230

180+00



12/20

CS FILE FOLDER

CONTAINS

MORE

INFORMATION