

May 9-1929

H L Eppstein T
P P Wolford's chanc
B A Laines
B W man? are.
TRASH }

Δ12

228¹-8⁰ 225²

Δ11

300-8⁰ 25[±] level
300-8⁰ 206-13⁰

594.27
200.7 } 820.1
25.2

Δ10

10305 NW

Δ9

163[±]

Δ8

183[±]-6⁰ 182[±]

Δ7

1129

Δ6

147[±]

Δ5

93[±]

Δ4

62[±] } 62[±] }
300-9⁰ } 296.3 } 358[±]

4 or 28' S
K F
X
X
X

Δ3

169[±]-4⁰ } 169[±]

Δ2

283.6 - 2-30 }
500⁰ - 0-0 } 783.3

Δ1

298[±]

1/4 in

1/4 in

0 HNB

22/44

3

Geo Trask

1/4 Cor

- 66° ↙ 29-44' 561-30E 561-35E

Δ 22
20-30
281.7
274.55

1-03

N 77° E N 88-41E

Δ 21

21-20 101.5

101.5

0-22 East N 89-44E

Δ 20

22-15 139.3

139.3

1°-22 N 87-E N 89-22E

Δ 19

23-30 276.2

276.2

N 77-30E N 88-06E

Δ 18

30 122.4

122.4

3-18R 587 E 586-24E

Δ 17

23-9 23.9

23.9

76-17R N 89-45E 589-45E

Δ 16

8° 228.3

228.3

Δ 15

23-30 151.0

151.0 276.2 } 484E

1035-7

Δ 14

13-30 66°

66°

Δ 13

23-30 256.8

256.8

10°-07R N 12-30E N 13-58E

Δ 12

Geo E Trask

7

1/4 cor

66°

Δ 22	2834	16°	272.4
	300°	20°	281.9
Δ 21			<u>554.3</u>

1087	21°	1015
------	-----	------

20 Δ	1503	22°	137.4
------	------	-----	-------

Δ 19	582	0°	58.7
	300 - 23°		276.2
Δ 18			<u>334.9</u>

1228

Δ 17

233

Δ 16

2282	230° - 8°
------	-----------

Δ 15

17.8	189°	23°	17.5	v.o.
274.9	300 - 12 - 30			
<u>484.7</u>				

Δ 14

68°	16°	-659
-----	-----	------

Δ 13

281°	24°	256.8
------	-----	-------


Δ 12

22/44

16 min E 18.6 feet

14 min E 7.4 feet

13 min E 5.9 feet

 

DESCRIPTION FOR A DEED FROM
Geo. E. Trask to T. J. Bowman, in Sec.
24, T. 29 S. R. 5 W. W. M.

Beginning at the $\frac{1}{4}$ Corner between Sections 24 and 19, marked by a vise screw, in T. 29 S. R. 4 & 5 W. W. M. Douglas County, Oregon;
Thence South 1607.9 feet along the Range Line to a road;
Thence on an old road and on the present County road as follows:
S. $57^{\circ} - 37'$ W. 104.2 feet; S. $85^{\circ} - 10'$ W. 145.6 feet; N. $61^{\circ} - 41'$ W. 113.1 feet; S. $89^{\circ} - 09'$ W. 183.0 feet; S. $82^{\circ} - 37'$ W. 163.8 feet; S. $67^{\circ} - 33'$ W. 1031.1 feet to the South-west corner of this tract.
Thence N. $2^{\circ} - 41'$ E. 1046.4 feet to the North-west corner of an orchard;
Thence N. $15^{\circ} - 11'$ E. 1042.0 feet to a 1" x 40" iron nail;
Thence S. $89^{\circ} - 31'$ E. 1309.3 feet on the $\frac{1}{4}$ section line through Section 24, in T. 29 S. R. 5 W. to the place of beginning, Containing 61.25 acres more or less.

CS FILE FOLDER

CONTAINS

MORE

INFORMATION