

23-23

Road for
Martin G. Olson
&
Elmer H Olson

Apr. 11-1936

Sec. 11 T. 26 S. R 7 W
N.E. Richardson

Sta	Dist	R	L	M.C.	C.C.
Δ 10	294 <u>5</u>	49-24		N10°W	N11°02'W
Δ 9	180 <u>8</u>	81-34		N59½°W	N60°26'W
Δ 8	268 <u>0</u>		22-26	S39°W	S38°00'W
Δ 7	121 <u>7</u>		65-13	S61½°W	S60°26'W
Δ 6	62 <u>2</u>		54-32	N53¾°W	N54°21'W
Δ 5	85 <u>5</u>		0-58	N1°E	N0°11'E
Δ 4	208 <u>0</u>	45-55		N1¾°E	N1°09'E
Δ 3	169 <u>7</u>	79-29		N44½°W	N44-46W
Δ 2	132 <u>3</u>			S55¾°W	
Δ 1					

Hub 1 is 6940 ft North
of $\frac{1}{4}$ Cor Bet. Secs. 11 & 14
T. 26 S. R. 7 W

23/23

Sta Dist R L Mc. C.C. ³

Δ 12

255
~~648~~

39-46 N69°W N69°34'W

Δ 11

794

18-46 N28³/₄W N29°48'W

Δ 10

This line to go to the West
line of Martin G. Olson tract

23/23

Deed Description of Road

Martin G.Olson to Elmer M.Olson

Beginning at a point 694.0 feet North of the $\frac{1}{4}$ corner between Secs. II & I4 in T.26 S.R.7 W.W.M.Douglas County, Oregon. Said point being in center of a 20 foot road.

Thence S.55°45'W. 132.3 ft.

" N.44°46'W. 169.7 ft.

" N. 1°00'E. 208.0 ft.

" N. 0°11'E. 85.5 ft.

" N.54°21'W. 62.2 ft.

" S.60°26'W. 121.7 ft.

" S.38°00'W. 268.0 ft.

" N.60°26'W. 180.8 ft.

" N.11°02'W. 294.5 ft.

" N.29°48'W. 79.4 ft.

" N.69°34'W. ~~25.8~~ ^{To} ~~ft. which is on~~ the west line of the

Martin G.Olson tract.


26-7

1/4 Cor. Bet. 11 & 14

Pr. est from one O.B.T. rotted down.

I.P. Marked 14" Fir S. 43° W. 99 L ft.

O.B.T. 18" B. Oak N. 61° W. 119 E ft.

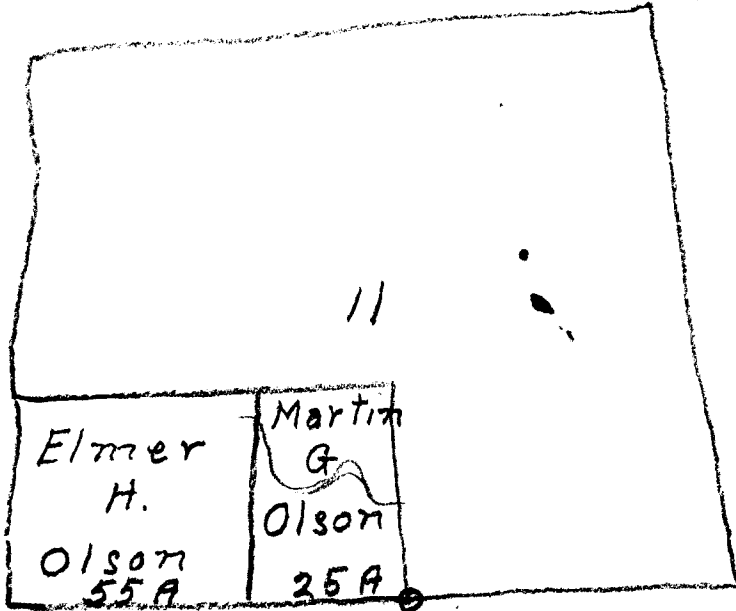

1/4 Cor

14