

B. Denn +  
Jno Standley

Apr 1936

A Boyer  
B. Denn (Bernard)  
Jno Standley & sons

1640.0 from SE Cor DLC 43

300

300

600


W 143.0  
SE Cor DLC 43 T29 S R&W

# T 29 S R 8 W

Set point 776.8 W. of  
SE Cor DLC 43, + 5.9' S. of  
Transit Line

Note at Pt 776.8' W of  
SE Cor DLC 43 Fence Cor  
is 5.5' S of Tr Line (343)

This is the 43  
SW cor DLC of  
24.85 chs of  
DLC Notes

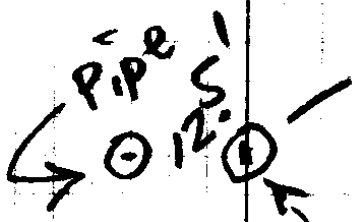

1598' as chained  
W. of SE Cor  
DLC 43  
GNDAY DLC

① 53'

1640) 12.500 (762  
11480

10200
9840
<hr/>
3600
3280
<hr/>
320

776.8  
00762

15536
46608
<hr/>
54376
<hr/>
5.919216

6.6  
5.9  

---

12.5

863.2
60762
<hr/>
17264
51792
<hr/>
60424
<hr/>
6577684

22/43

These notes shown  
 below made to estab.  
 Dennis N & S Line or the  
 E Line DLC 43  
 T29S R8W

55.7  
 2560.5  
 -----  
 2616.2

2640  
 162  
 -----  
 23.8

2616.2  
 -----  
 1308.1

300  
 108  
 -----  
 192

