7/29/86
PRINT FROM MICROFILM.

~~CONTACT~~
(CONTENTS had Been MISSING.)

J.L.

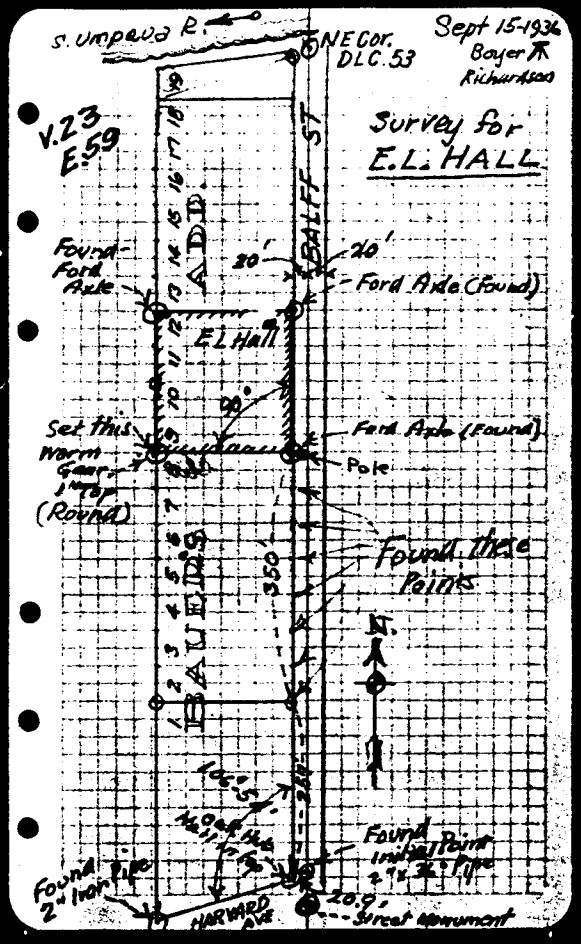

CS 23/57