Drawer 30/8

Apr 12, 1937

Elmer Crow

A Bayer
NE Richards

Lot 8 Block 13
MILLER'S ADDITION
Roseburg, Ore

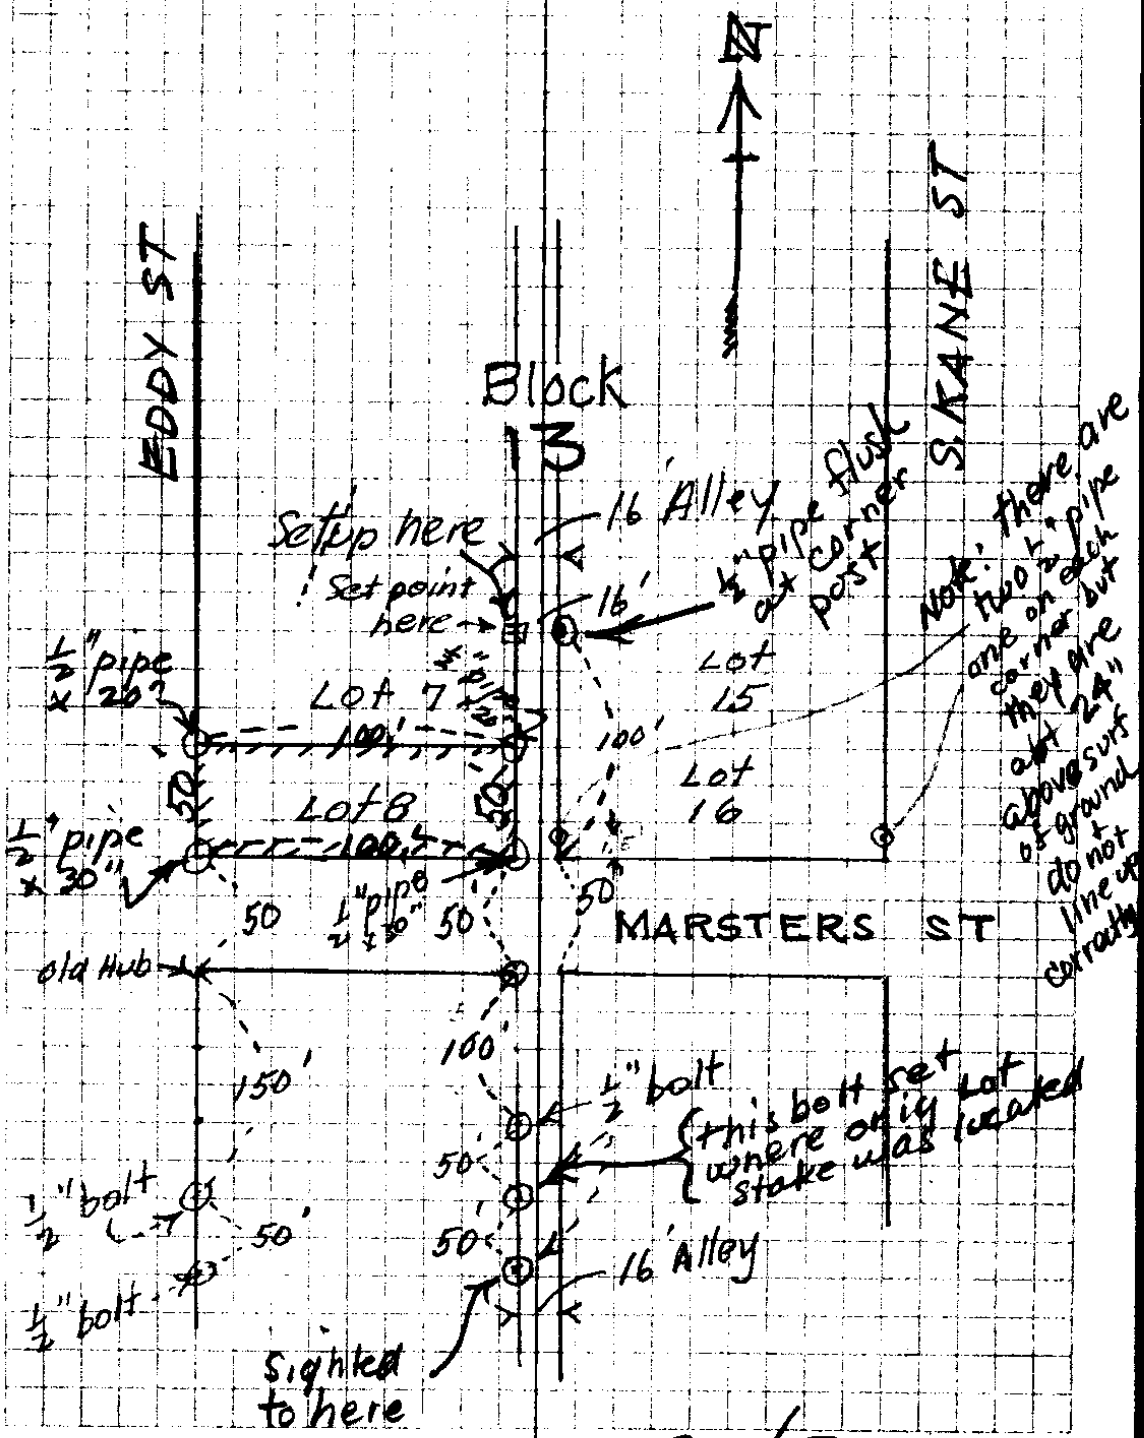

30/8