


May 12, 1937

A. Boyer.
thos Siegel

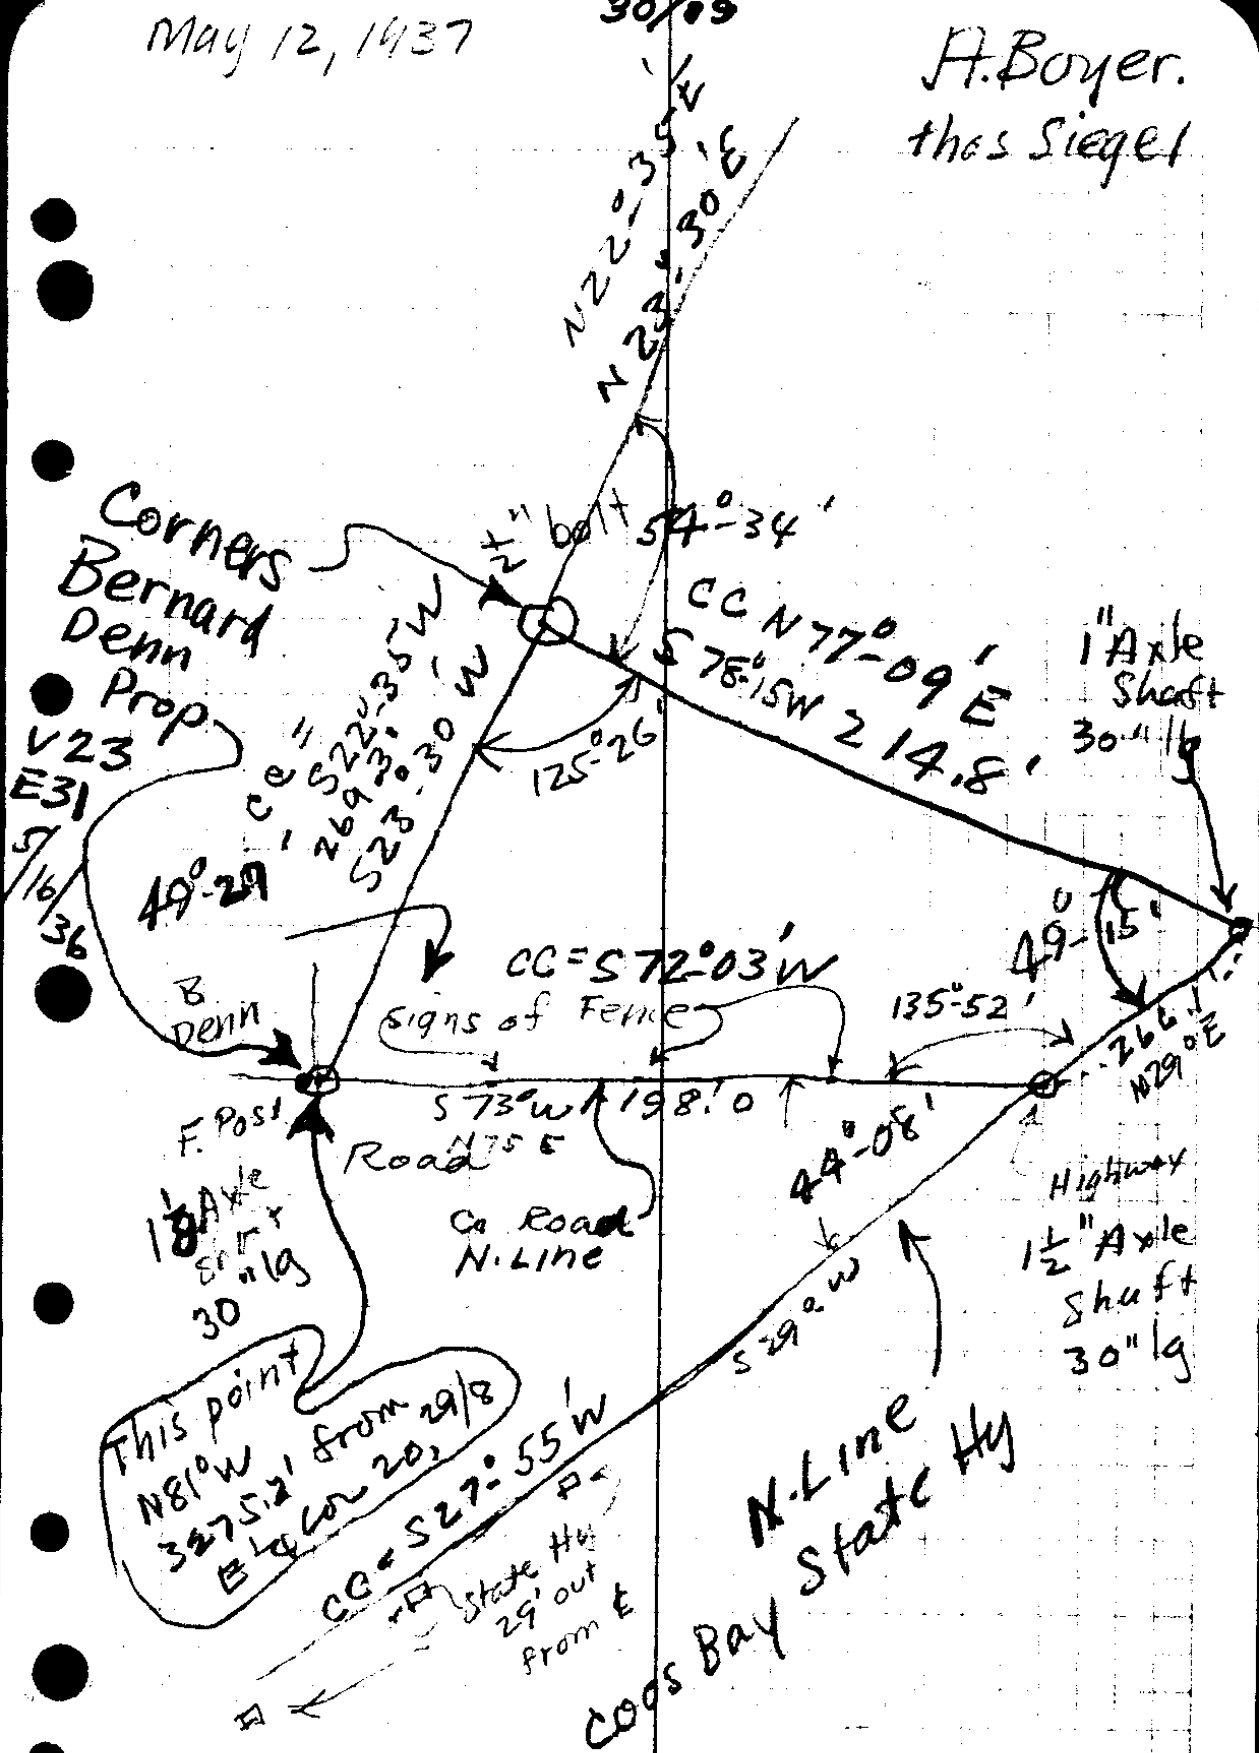

CS FILE FOLDER

CONTAINS

MORE

INFORMATION