30/37

AM. Oct. 8, 1937

Lot 11, Bl. 15
WAITES ADD
Roseburg-

HL Eppstein
A Boyer
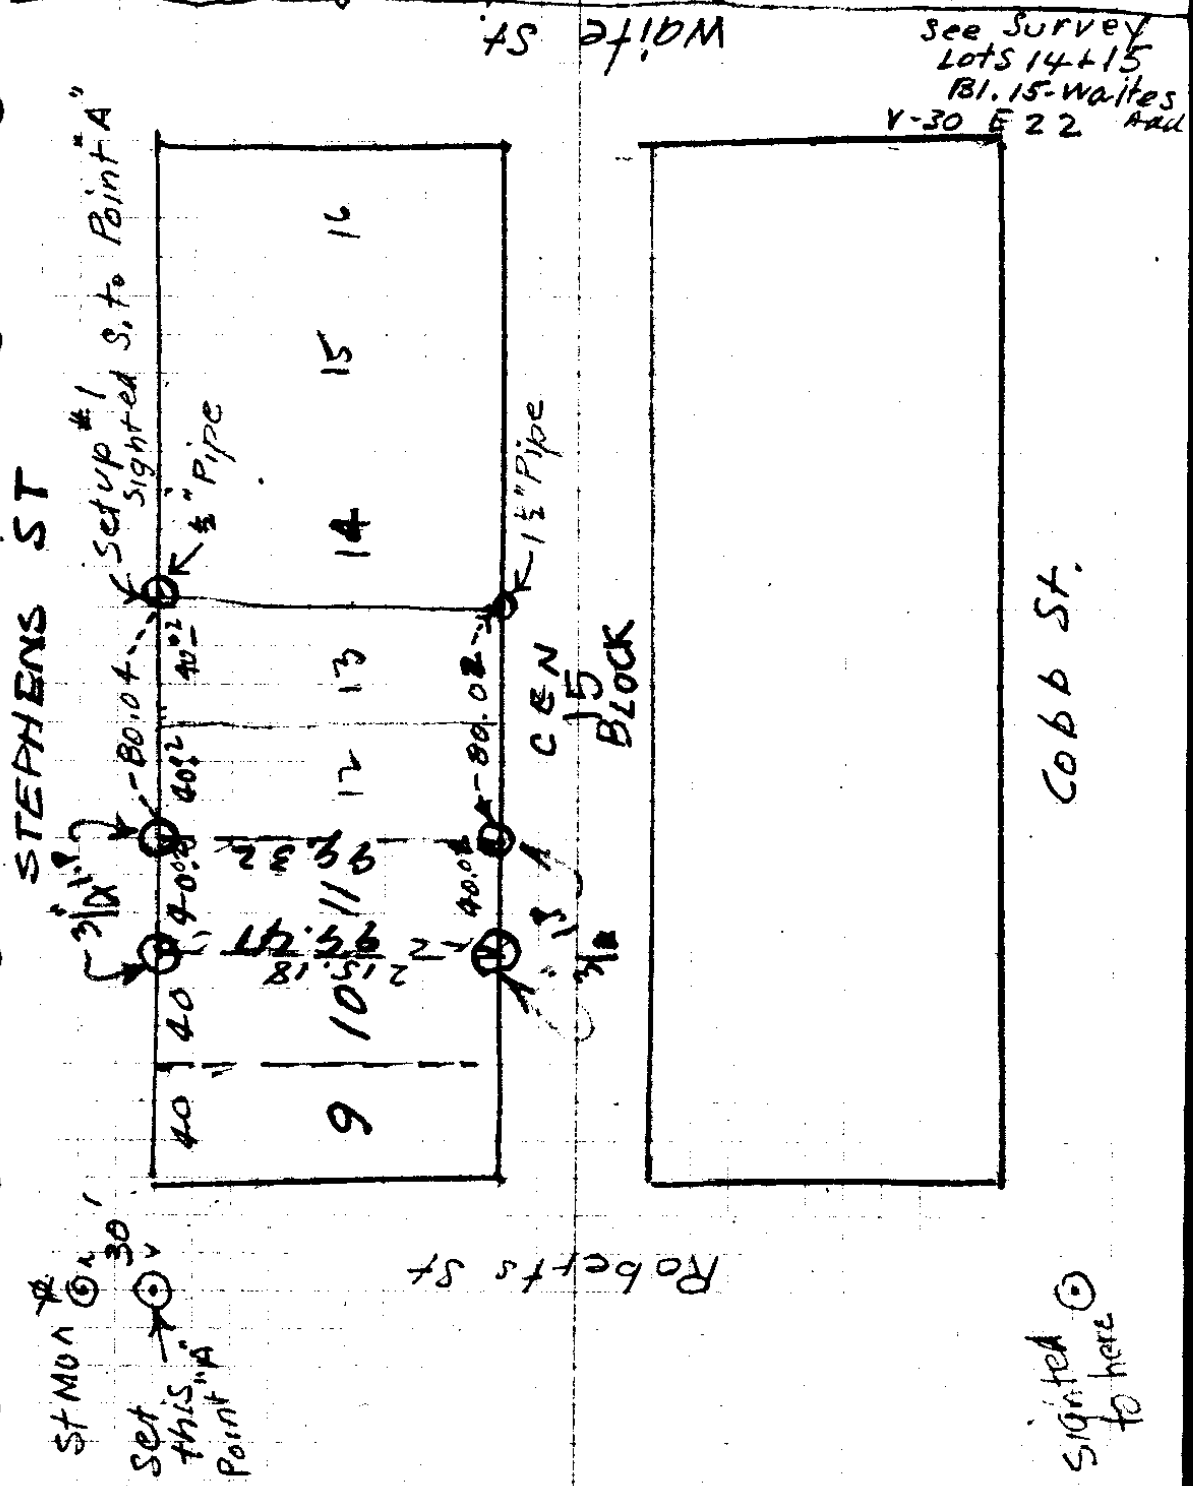
For Young Realty Co - Edgar Evans purchaser