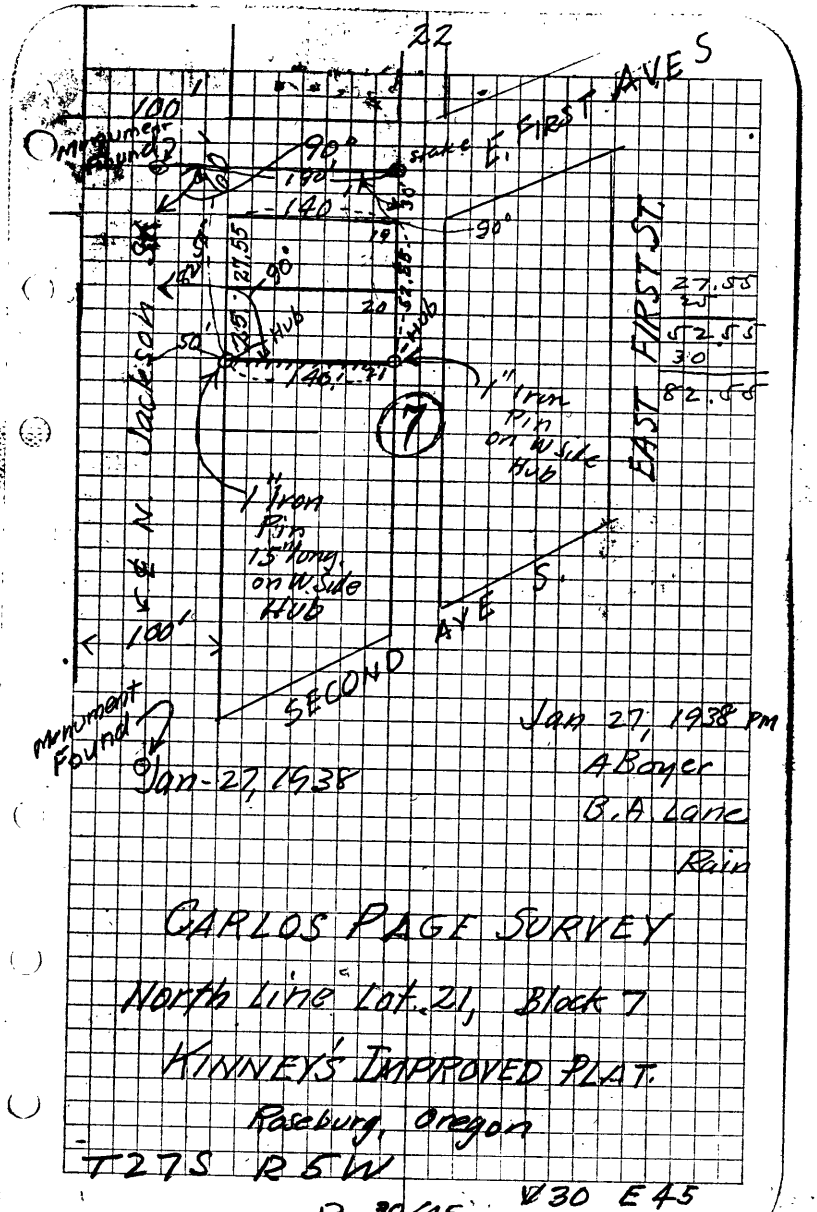
22
AVE S
FIRST
state E.
Monument Found
100'
90°
190
140
30
19
90°
27.55
90°
20
52.55
Hub
Hub
50'
145
21
7
1" Iron Pin on W. Side Hub
EAST FIRST ST.
27.55
52.55
30
82.55
N. Jackson St.
1" Iron Pin 15" long on W. Side Hub
100'
AVE S
SECOND
Monument Found
Jan-27, 1938
Jan 27, 1938 PM
A Boyer
B.A. Lane
Rain
CARLOS PAGE SURVEY
North Line Lot 21, Block 7
KINNEY'S IMPROVED PLAT.
Roseburg, Oregon
T27S R5W
P 30/45
V30 E45