

Boyer  
Art. Baum



LANE ST.

Lined up to Cass St.

ROSE ST.

JACKSON ST.

Lined up to Cass St.

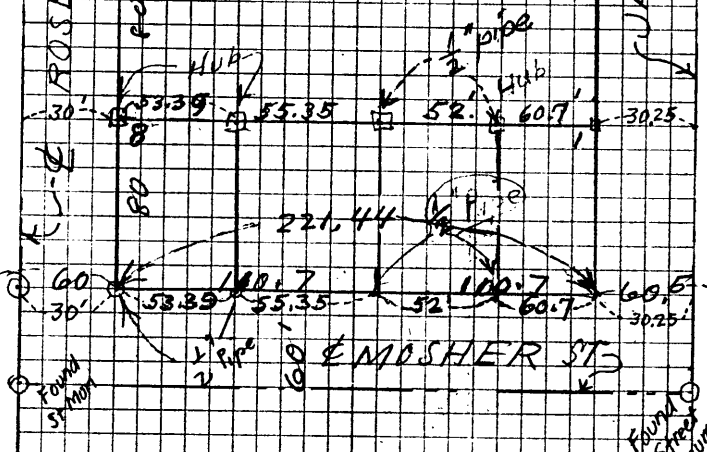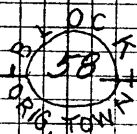

WOLLENBERG ESTATE

- by Mrs Baum -

Subdivision Lots 1 & 8 Bl. 58, Orig. Town

o/c Properties as already sold

P V30 E55 Apr. 1, 1938