Adam Flury

Nov 2, 1943

George Trapolis

Adam Flury
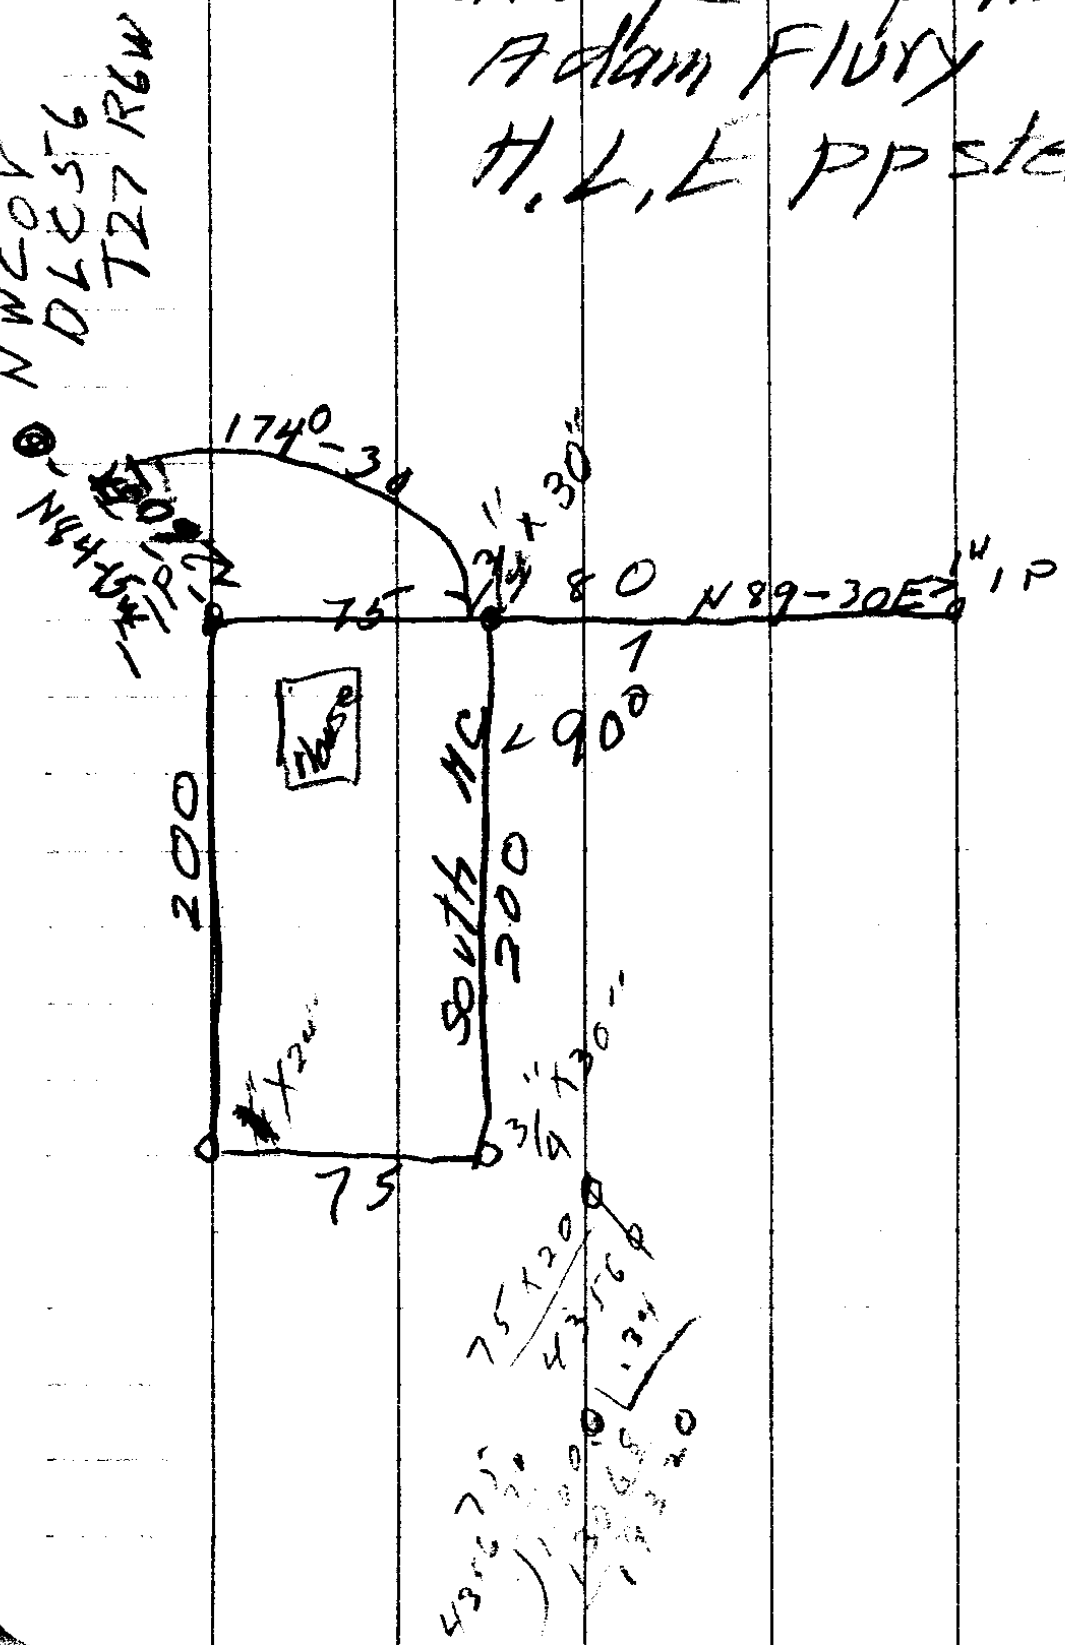
H. L. Eppstein