

1994
9.97

1996
9.98
E5

FRONT ST.

(S. P. CO.)

STREET

CALAPOOIA STREET

STRONG AV

STRE

STATE

STRE

UMPQUA


STRE

WILLAMETTE

STRE

UMATILLA

SUB LOT "A"

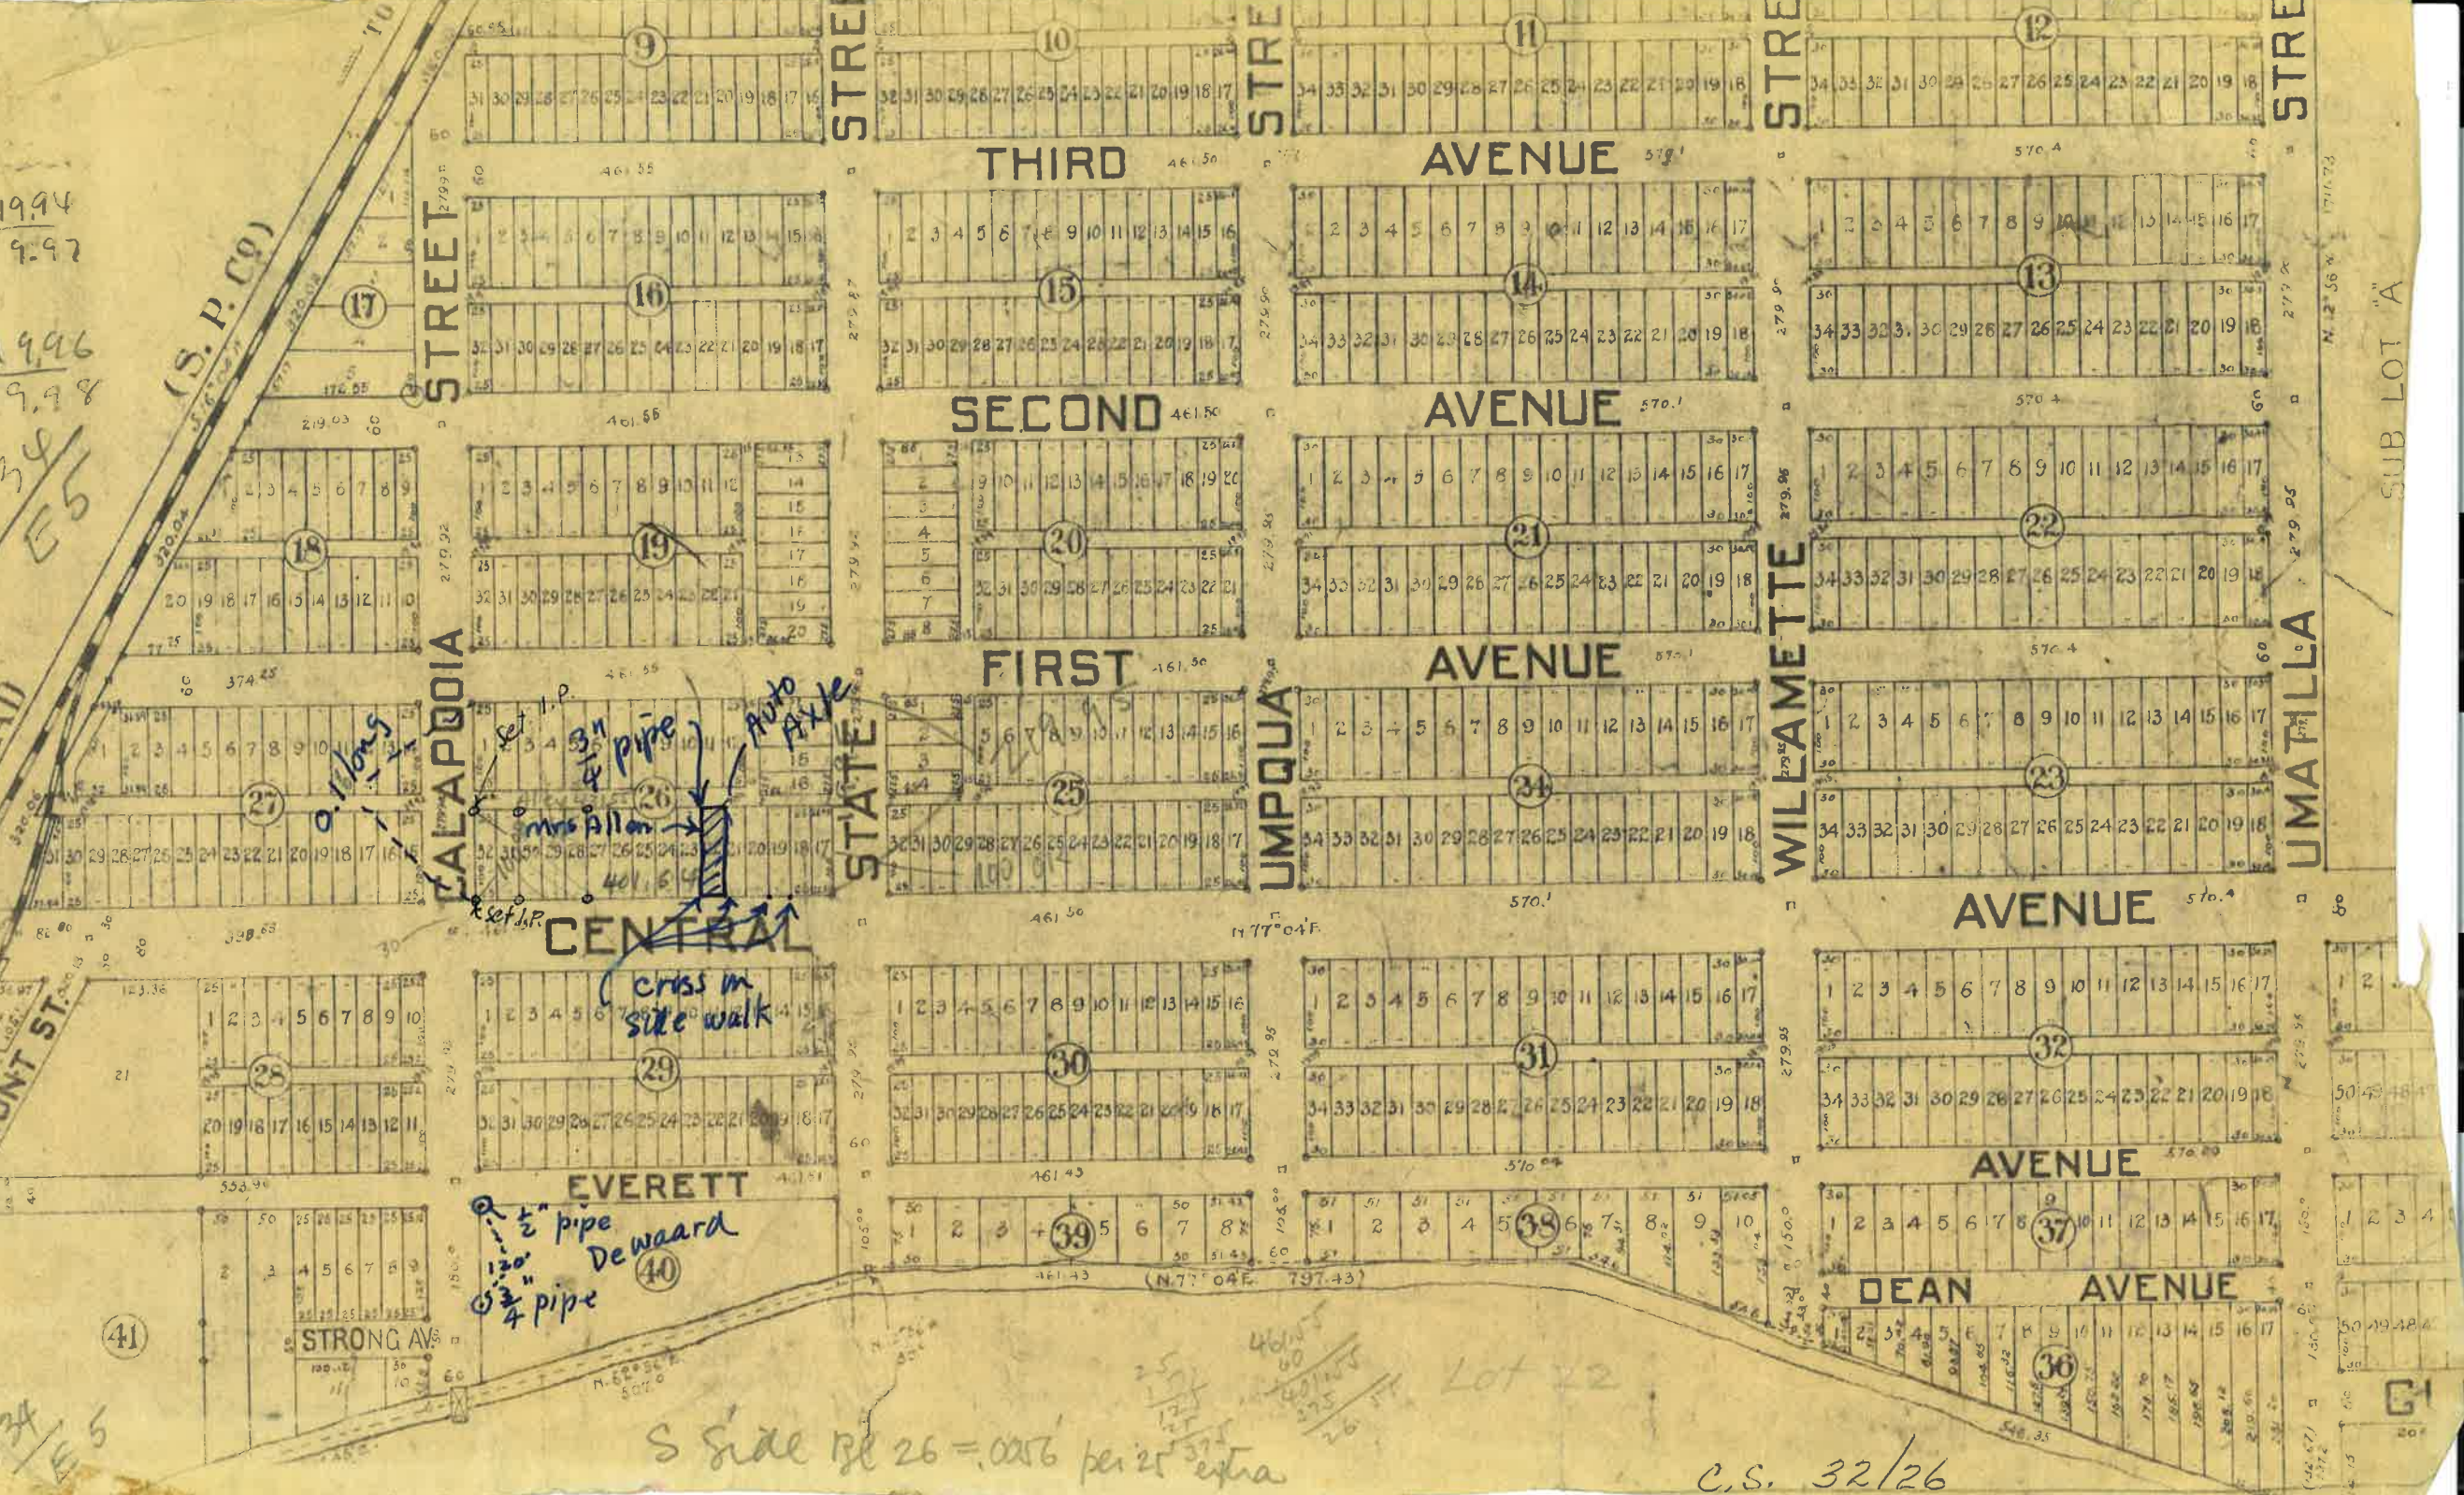

134
E5

S side of 26 = .0256 per 25 extra

Lot 12

c.s. 32/26

CS FILE FOLDER

CONTAINS

MORE

INFORMATION