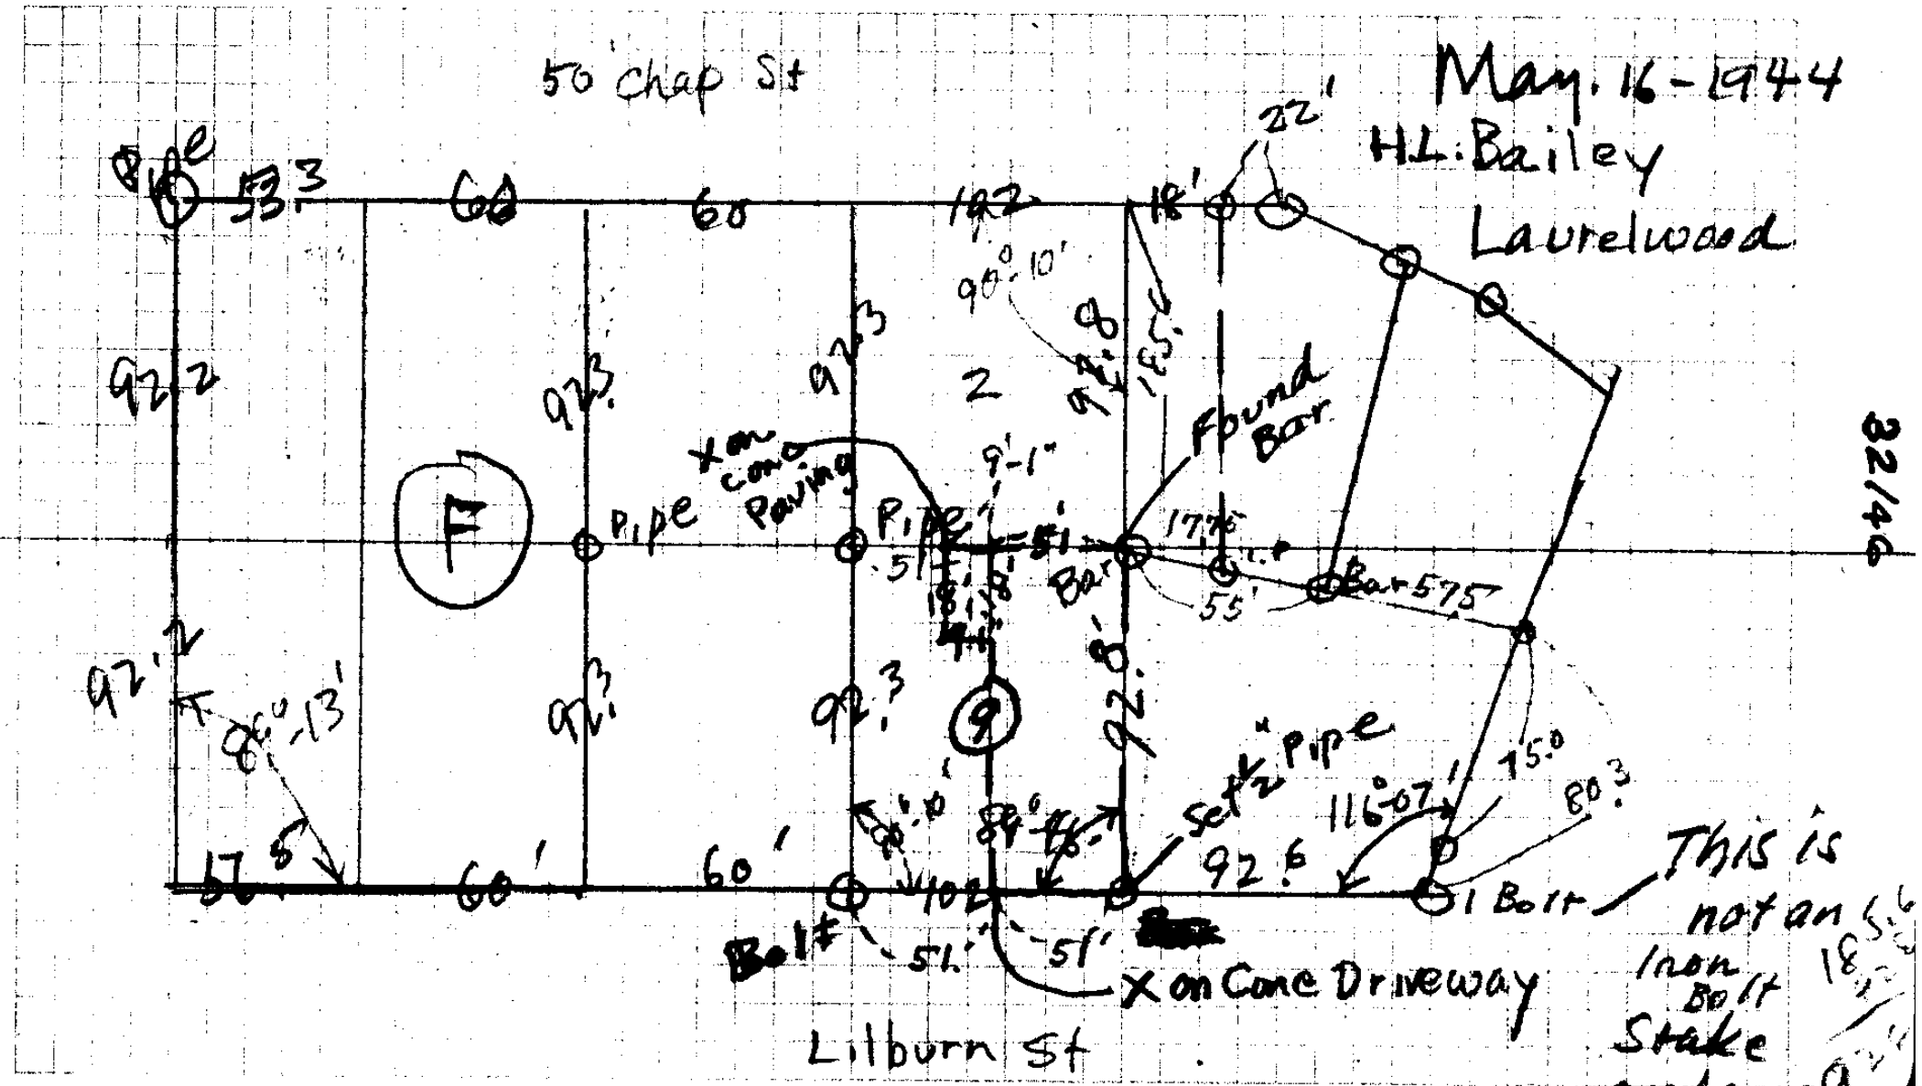
50' Chap St
May. 16-1944
H.L. Bailey
Laurelwood
Pipe
Found Bar
X on Conc Paving
Pipe
Bar
Bar 575
Set ½" Pipe
Bolt
X on Conc Driveway
Lilburn St
This is not an iron Bolt Stake on ½ line.
32/40