


CS 33/28

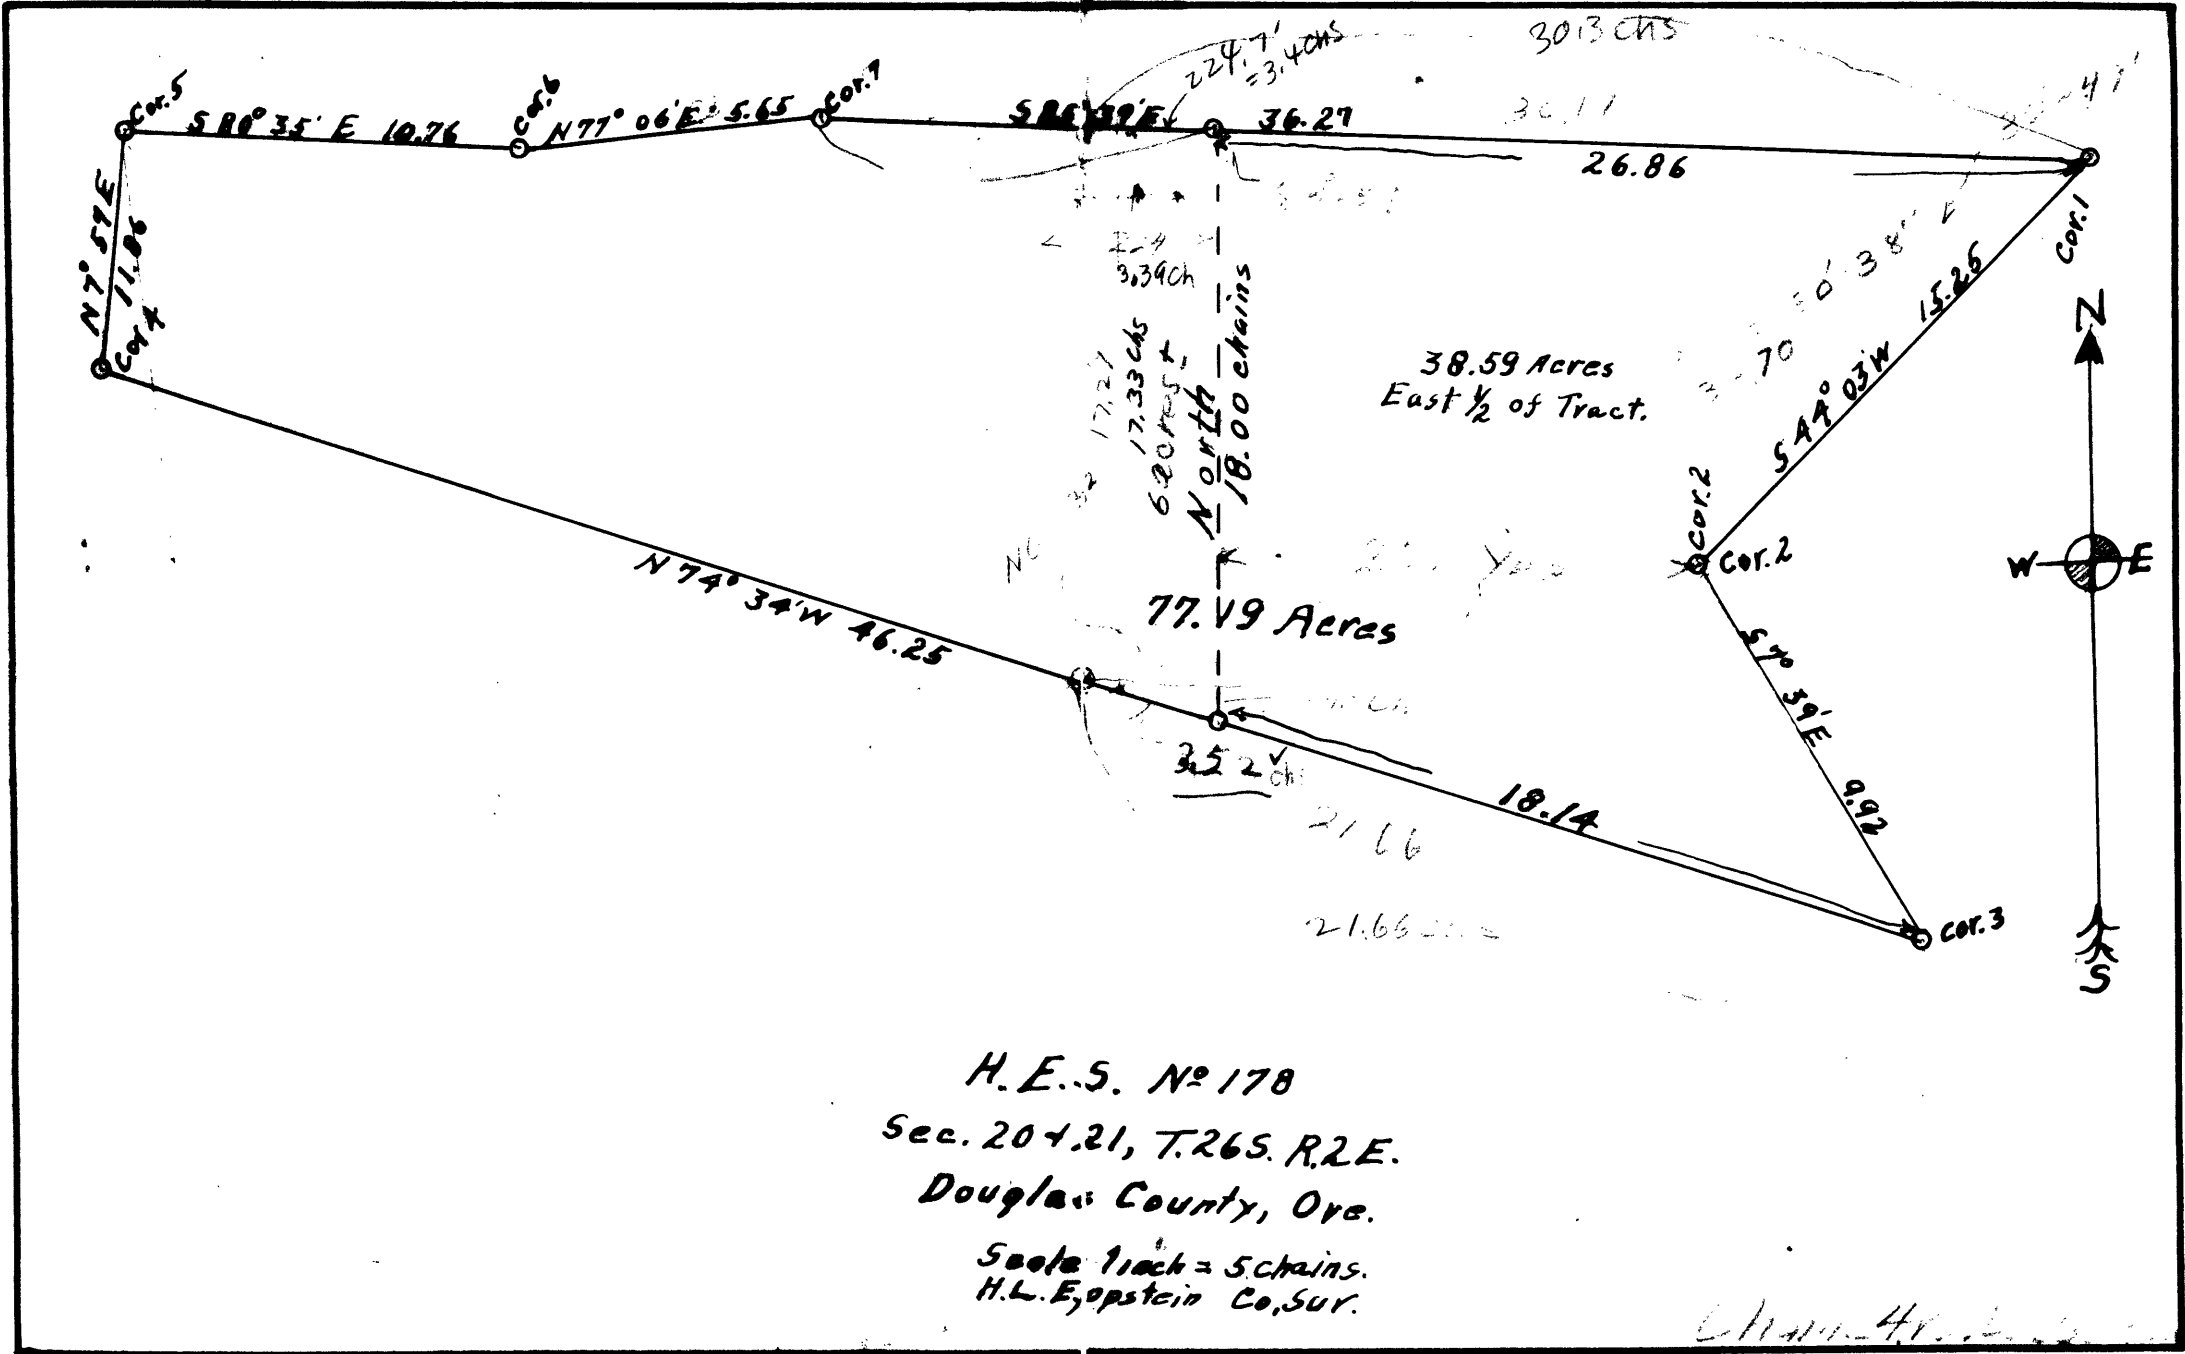

H.E.S. No 178
 Sec. 20 & 21, T.26S. R.2E.
 Douglas County, Ore.
 Scale 1 inch = 5 chains.
 H.L. Epstein Co. SUR.

H.L. Epstein Co. SUR.