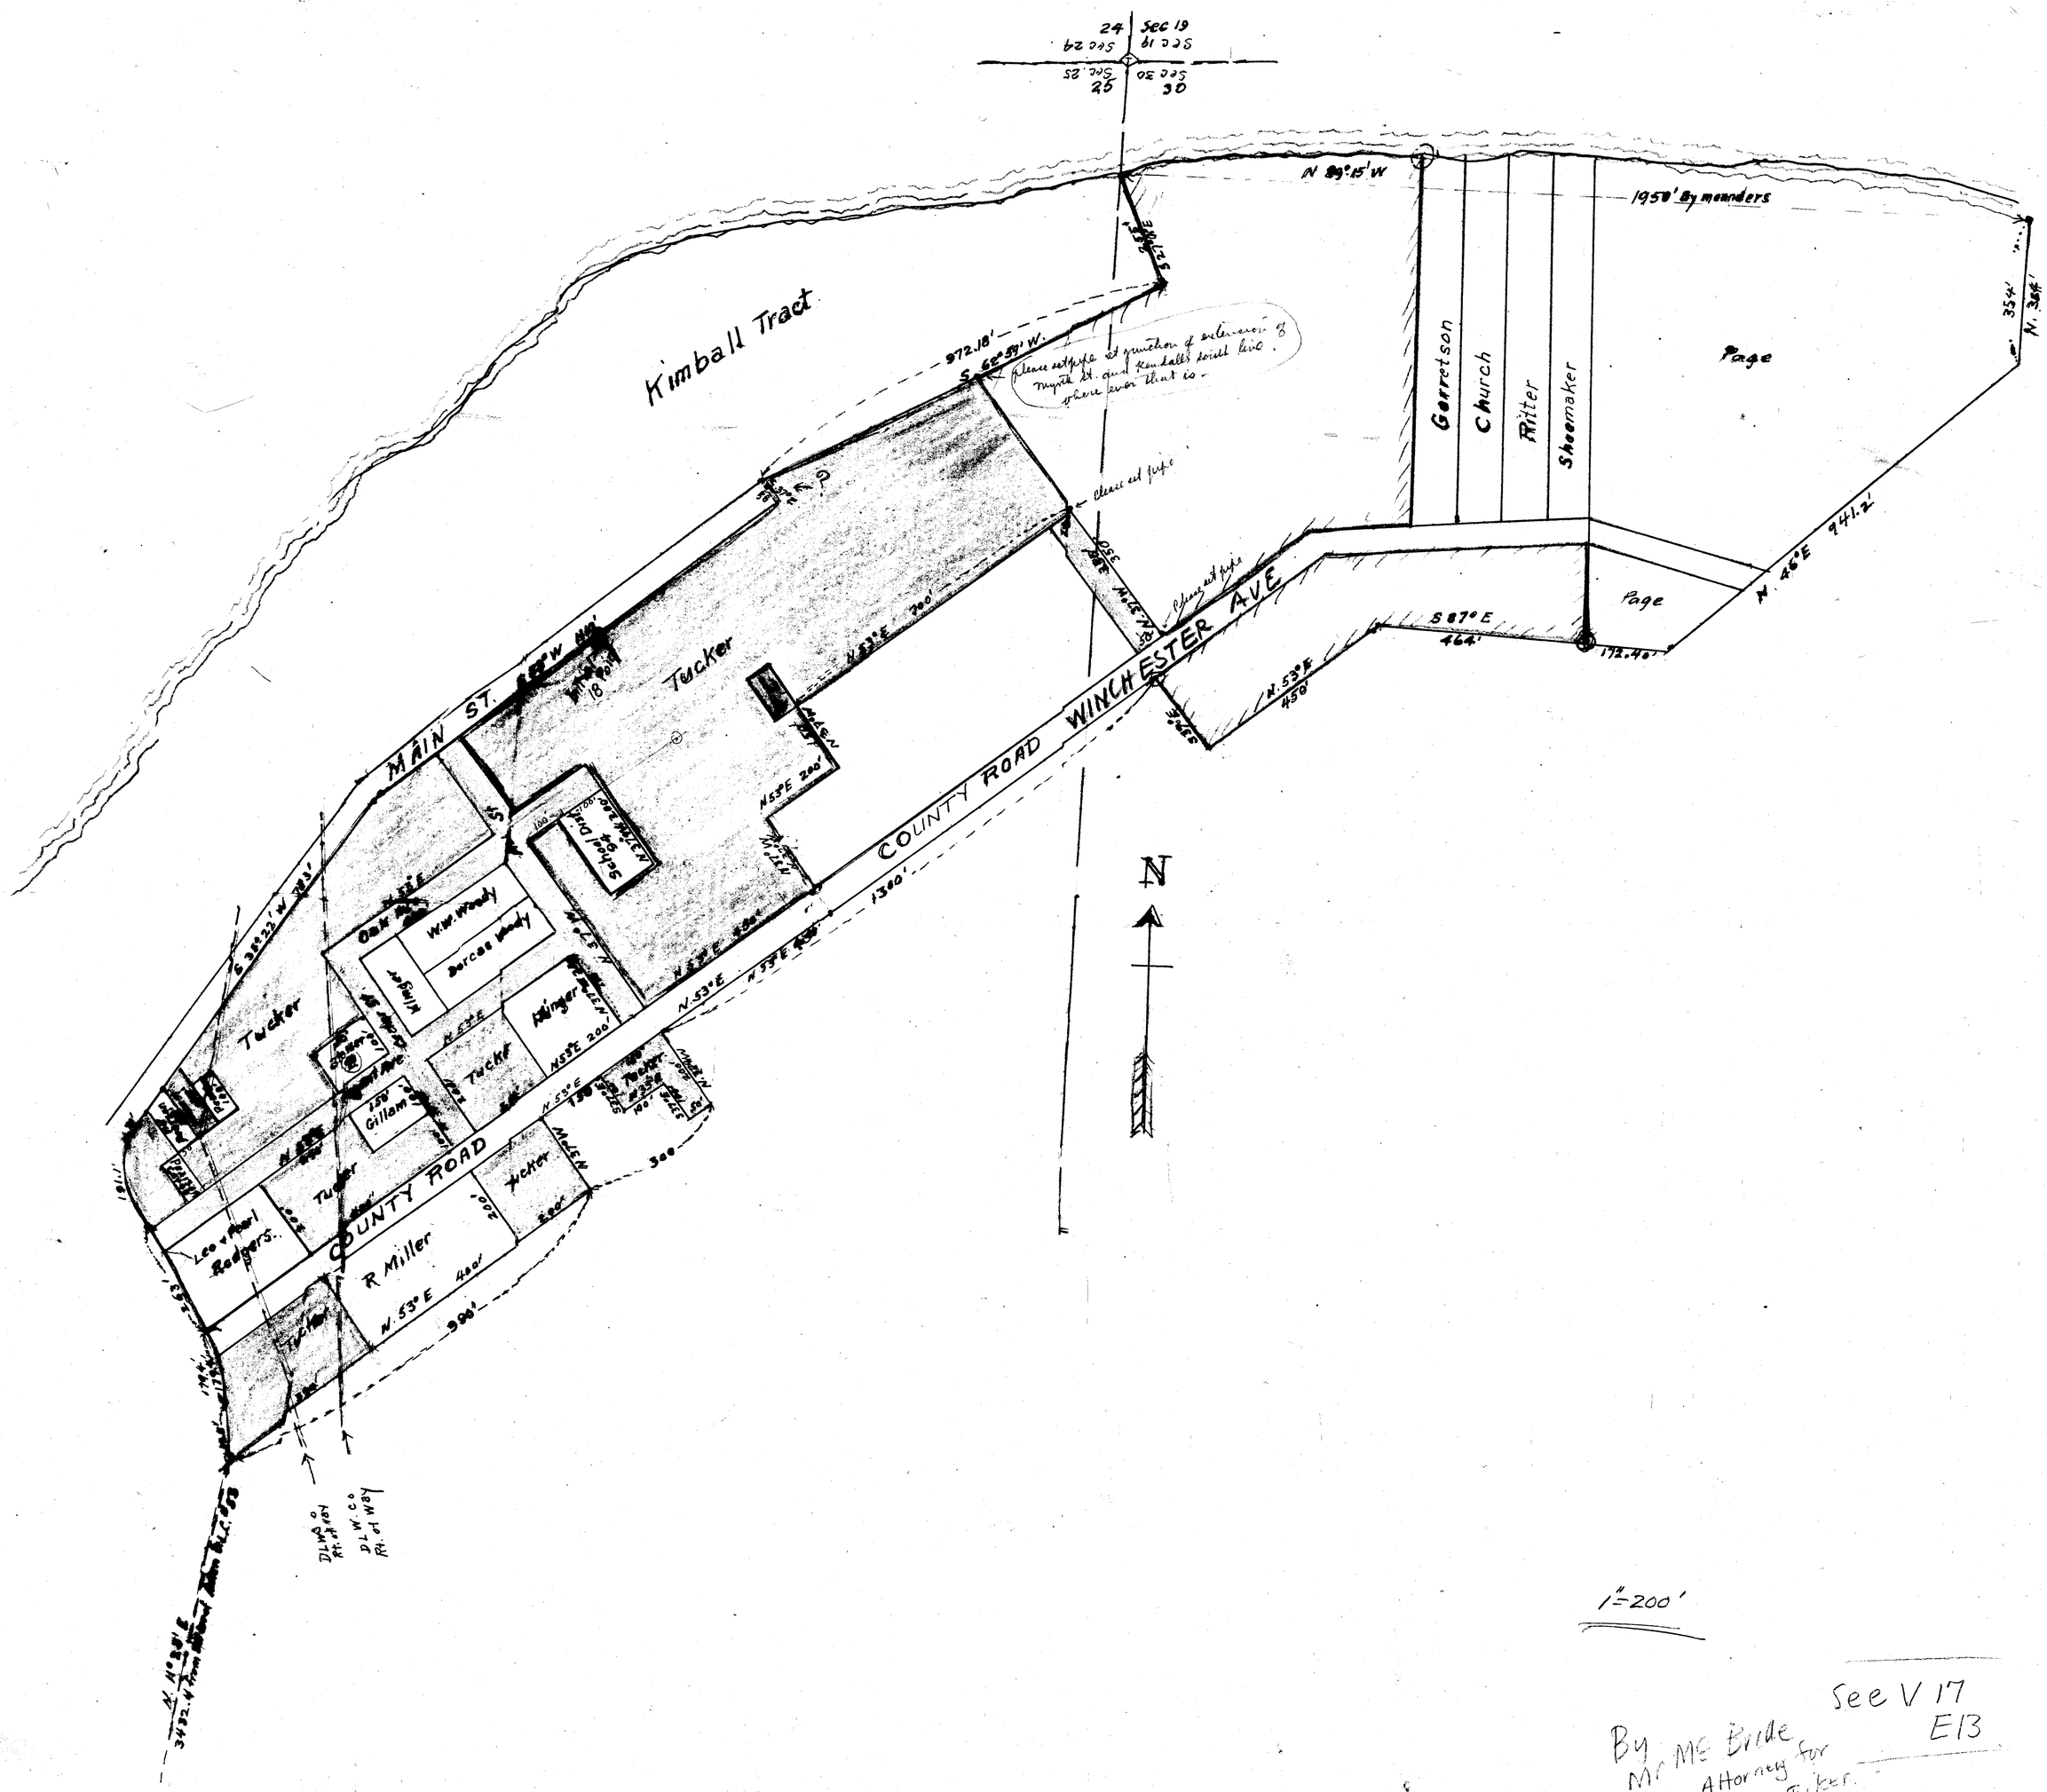

1" = 200'

See V 17
E13

By Mr ME Bride
Attorney for
Mrs Tucker

U.S. File No. 34/4

CS FILE FOLDER

CONTAINS

MORE

INFORMATION