IMPROVEMENTS ON & BOUNDARIES OF
PORTION OF LOT 1, BLOCK "F"
LAURELWOOD ADDITION TO THE CITY OF ROSEBURG,
DOUGLAS COUNTY, OREGON.

Surveyed July, 1940. Scale, 1" = 20 ft.

This is to certify that I have surveyed the above described property and that the improvements hereon described and shown on this survey are within the property lines.

Arthur B. Rogers
Oreg. Reg Civil Engr.

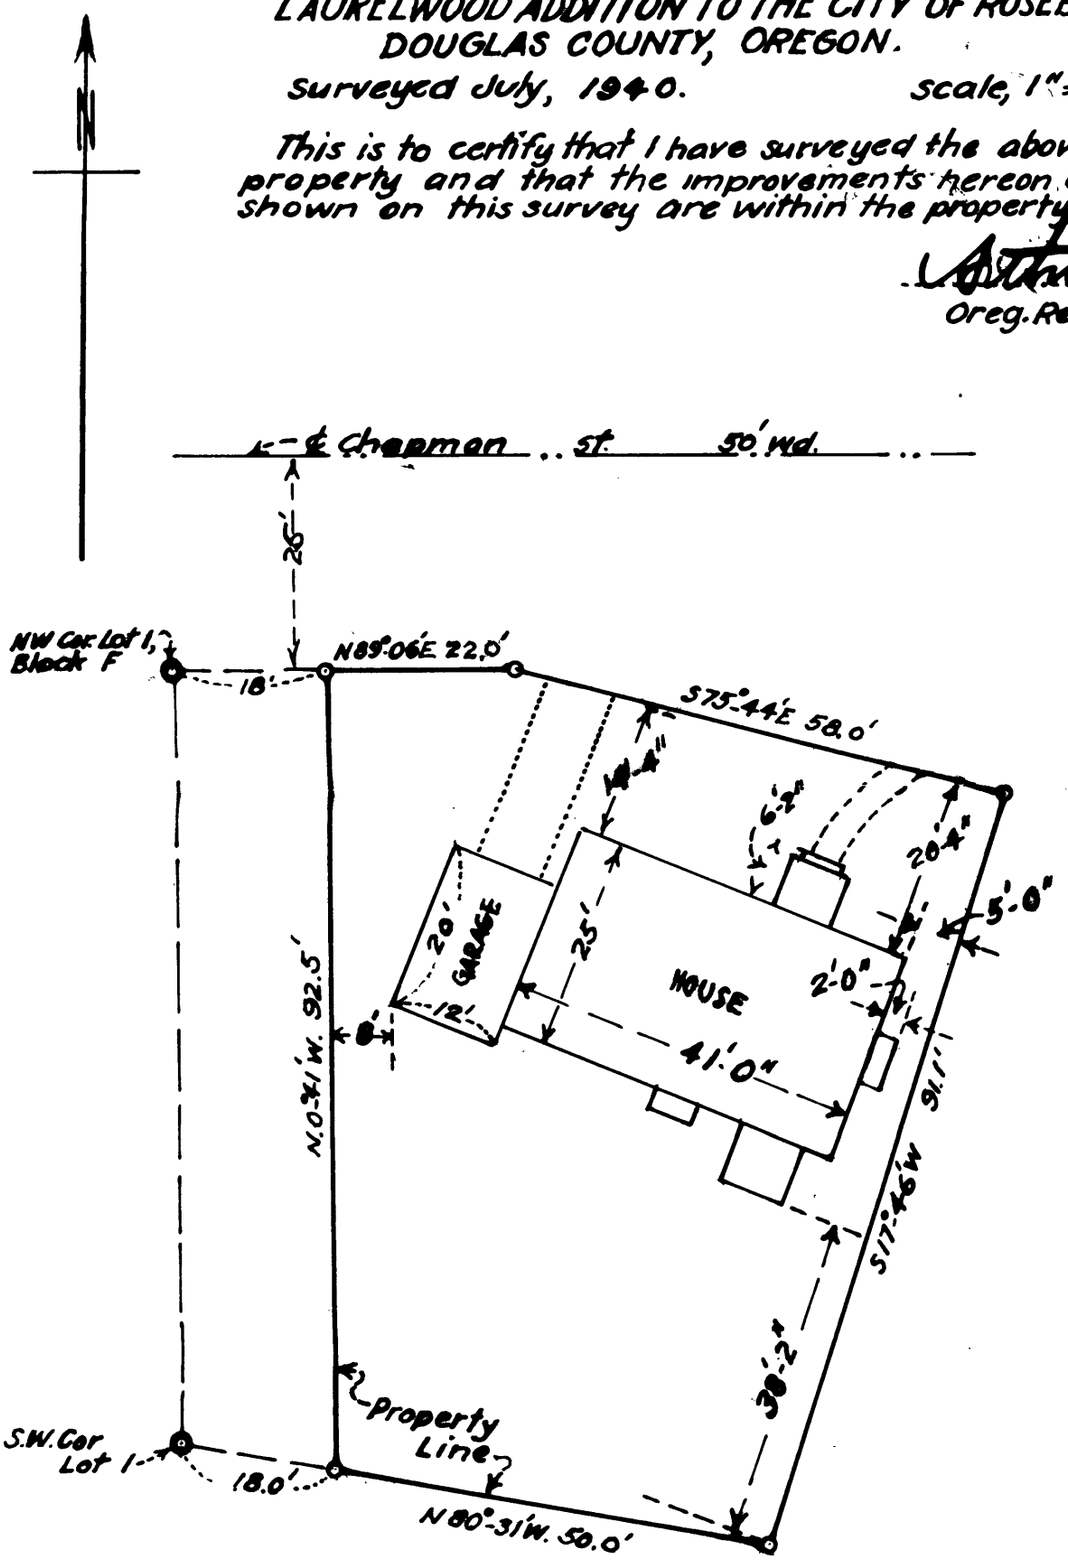

THIS POLICY NO. ..... CONSISTS OF ..... PAGES WHICH ARE NUMBERED AT END OF EACH PAGE

FILE 24 DRAWER 34