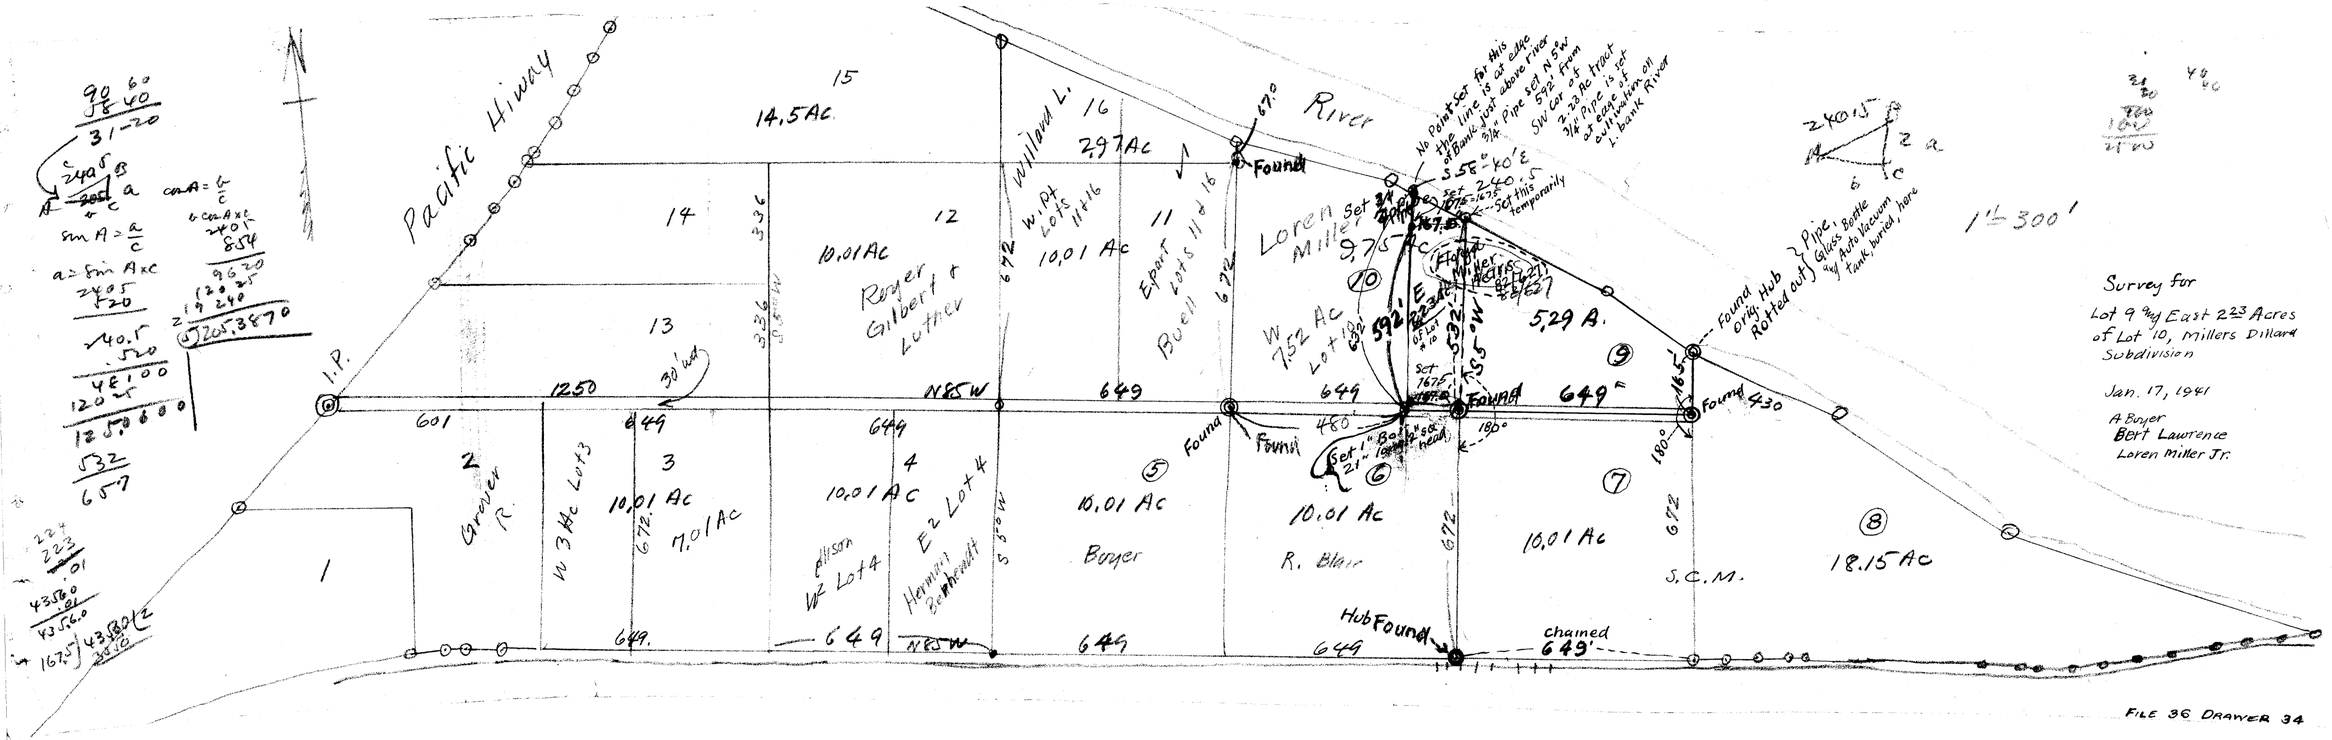
Pacific Hiway
River
15
14.5Ac
14
13
12
10.01Ac
Roger Gilbert & Luther
Willard L.
16
2.97Ac
W. Pt Lots 11 & 16
10.01 Ac
Eport Lots 11 & 16
Buell
11
Loren Miller
9.75 Ac
10
W 7.52 Ac Lot 10
592'
N 5°W
5.29 A.
9
649'
Found
Found 430
No Point Set for this the line is at edge of Bank just above river
3/4" Pipe set N 5W 592' from SW Cor of tract
2.29 Ac tract
3/4" Pipe is set at edge of outwater all L bank River
Set 2.40 5
Set this temporarily
Found Miller Corner
Set 1" Bolt 21" long
Set 7675'
180°
found Hub orig. Hub Rotted out
Pipe Glass Bottle Auto Vacuum Tank, buried, here
1" = 300'
Survey for
Lot 9 Avg East 2.23 Acres of Lot 10, Millers Dillard Subdivision
Jan. 17, 1941
A Boyer
Bert Lawrence
Loren Miller Jr.
I.P.
1250
30' bed
N85W
649
601
2
Grover R.
W 3 Ac Lot 3
3
10.01 Ac
7.01 Ac
4
10.01 Ac
Allison W 1/2 Lot 4
E 1/2 Lot 4
Hewitt Bathrodt
5
10.01 Ac
Boyer
6
10.01 Ac
R. Blair
7
10.01 Ac
S.C.M.
8
18.15 Ac
1
Hub Found
chained 649'
480'
180°
672
336
N 5°W
90 60
56 40
31-20
240.5
a
c
sin A = a/c
a = sin A x c
240.5
.520
40.1
120.4
12 030
532
657
43560
43560
43560
43560
16.75
43560
2
cos A = b/c
b = cos A x c
240.1
.854
96 20
120 05
219 240
205.3870
224
223
.01
240.5
A
B
C
a
b
c
