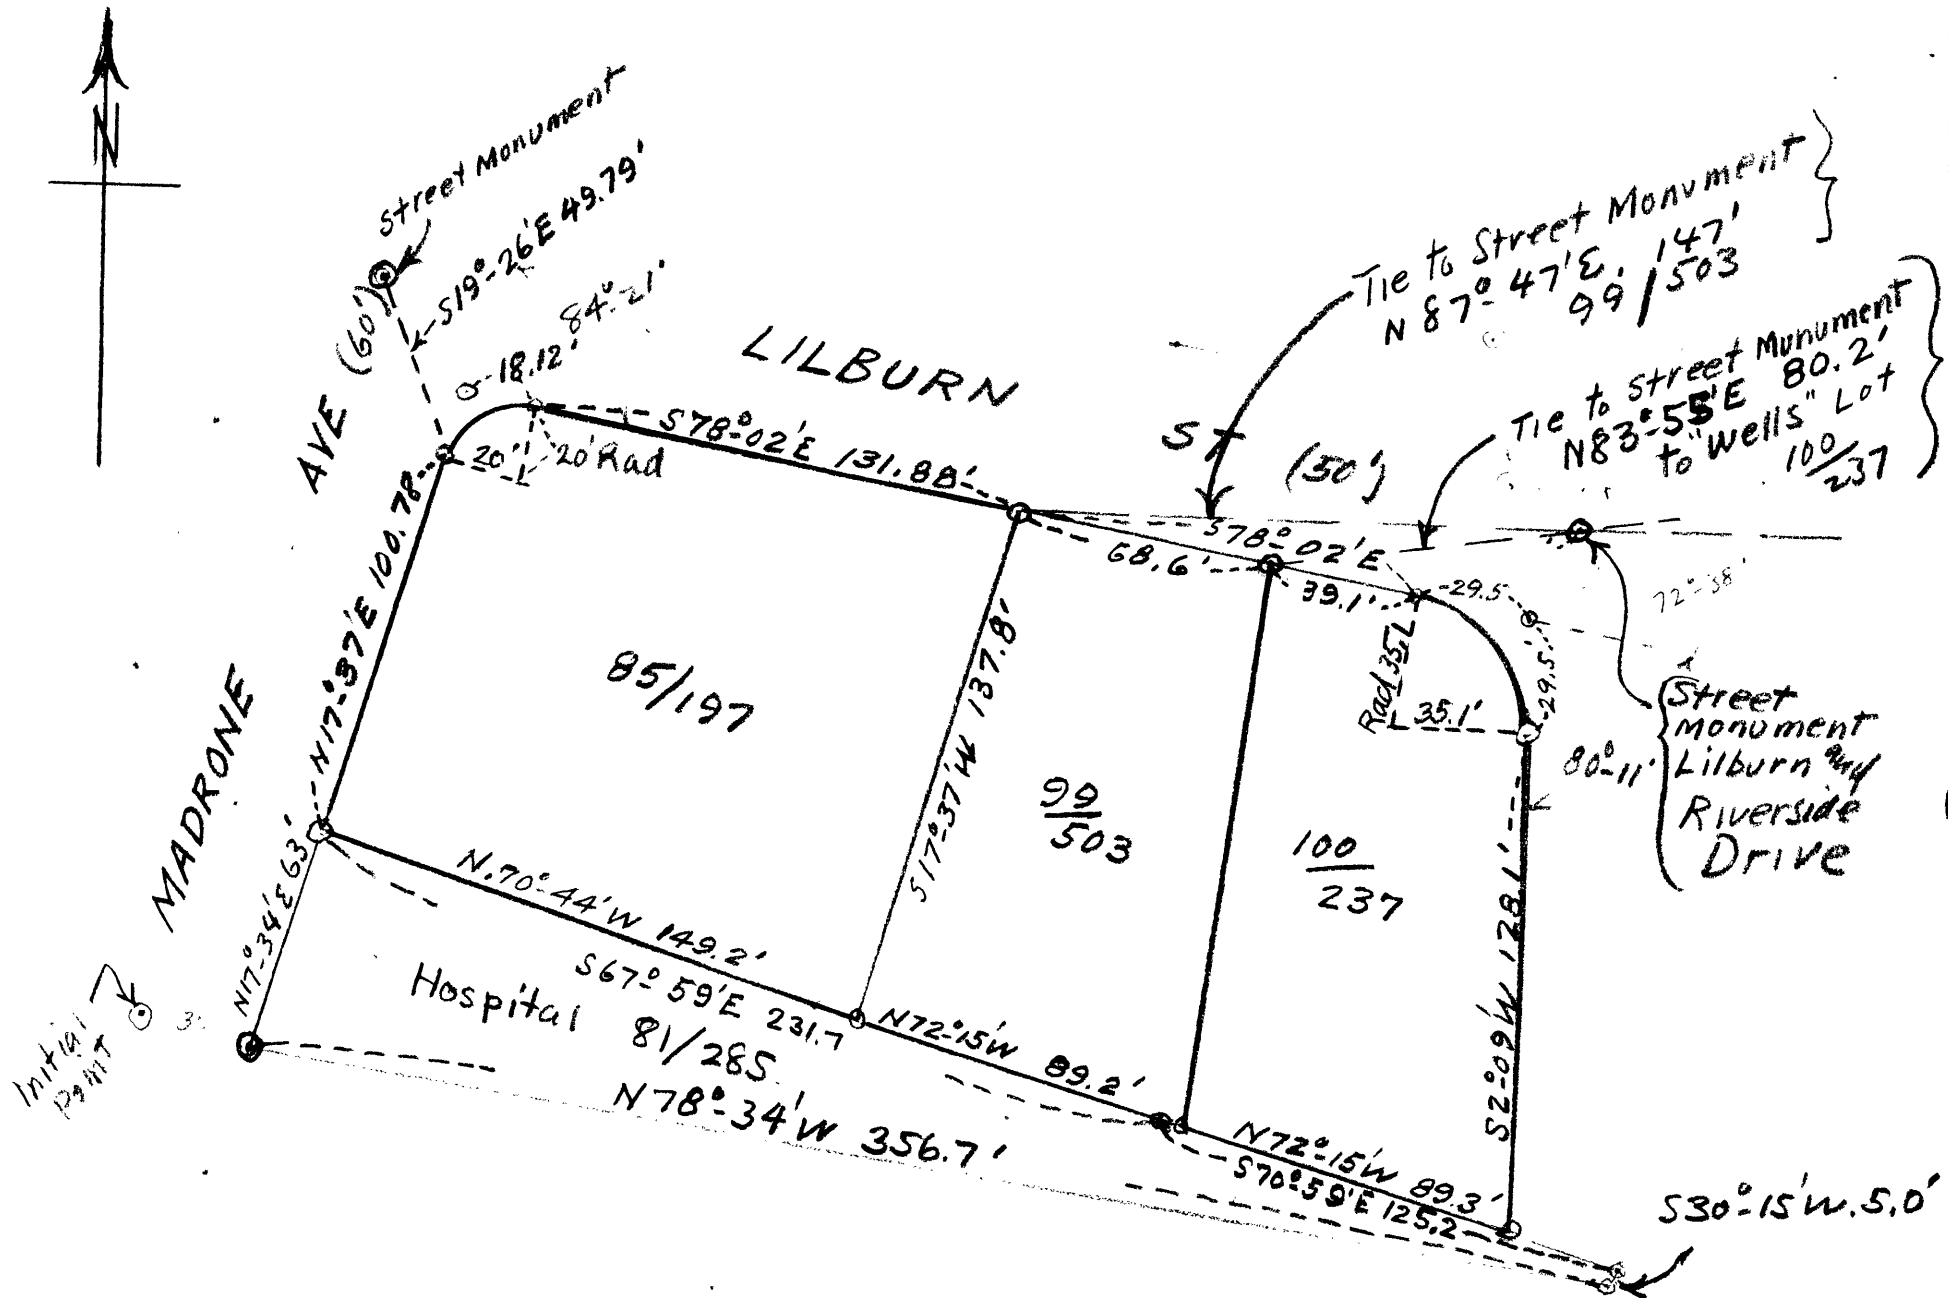

BLOCK A-LAURELWOOD ADD
TO CITY OF ROSEBURG ORE.
AUG 2-1941 A Boyer Dep Co Sur Scale 1"=50'

V35/E17

U. S. File No. 35/17