

35-24 25/4 6

S on W Bdy 19

40 = 1/4 cor 12" W.O N 48 1/2 W

11" " S 19 E

76 1/2
115
98 1/2
68 1/2

19-24-25-30

40" R S 19 W 27 1/2

16" R N 2 1/2 W 31

18" R N 23 1/2 E 35

20" R S 39 E 120

925
66
55 1/2
15 1/2
610.5

Cor 13, 18, 19, 24

14" B.O N 7 3/4 W 925 1/2


12" " N 3 1/2 E 926 1/2

no R Sutherland RC 42

no Sutherland LC near stone

SE cor = SE cor = Stone

W 1/2 " = Rock

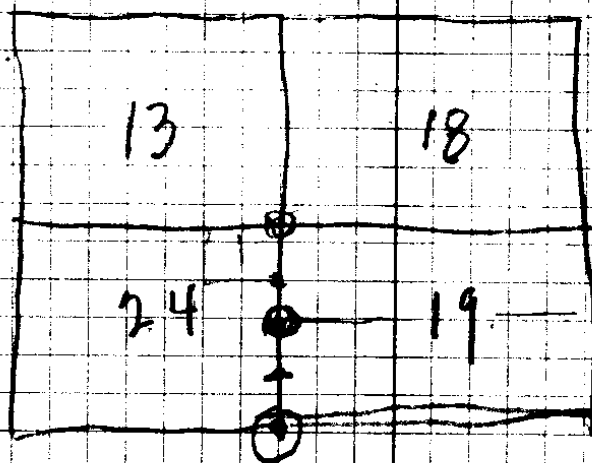

C.S. File No. 35/24

AV Abeene - Aug. 29-1941

1322.5) 3.00000

1322.5) 2.95000 (0223

00223
326
1338
442
669
072698

30500
26450
40500
39675
825

295
07
2.88

30'

1322.5

$$19 = 1320' S \text{ of } 1/4 \text{ cor} \\ 155.9 \text{ (on cor } 956)$$

$$18 = 1171.3$$

$$98.5 \text{ } 6\frac{1}{2}^\circ = 97.8$$

$$17 = 1073.5 \quad 993$$

$$118.7 \text{ F}$$

$$16 = 954.8$$

$$65.5 \text{ F}$$

$$15 = 889.3$$

$$117.0 \text{ } 23^\circ - 15' = 107.5$$

$$14$$