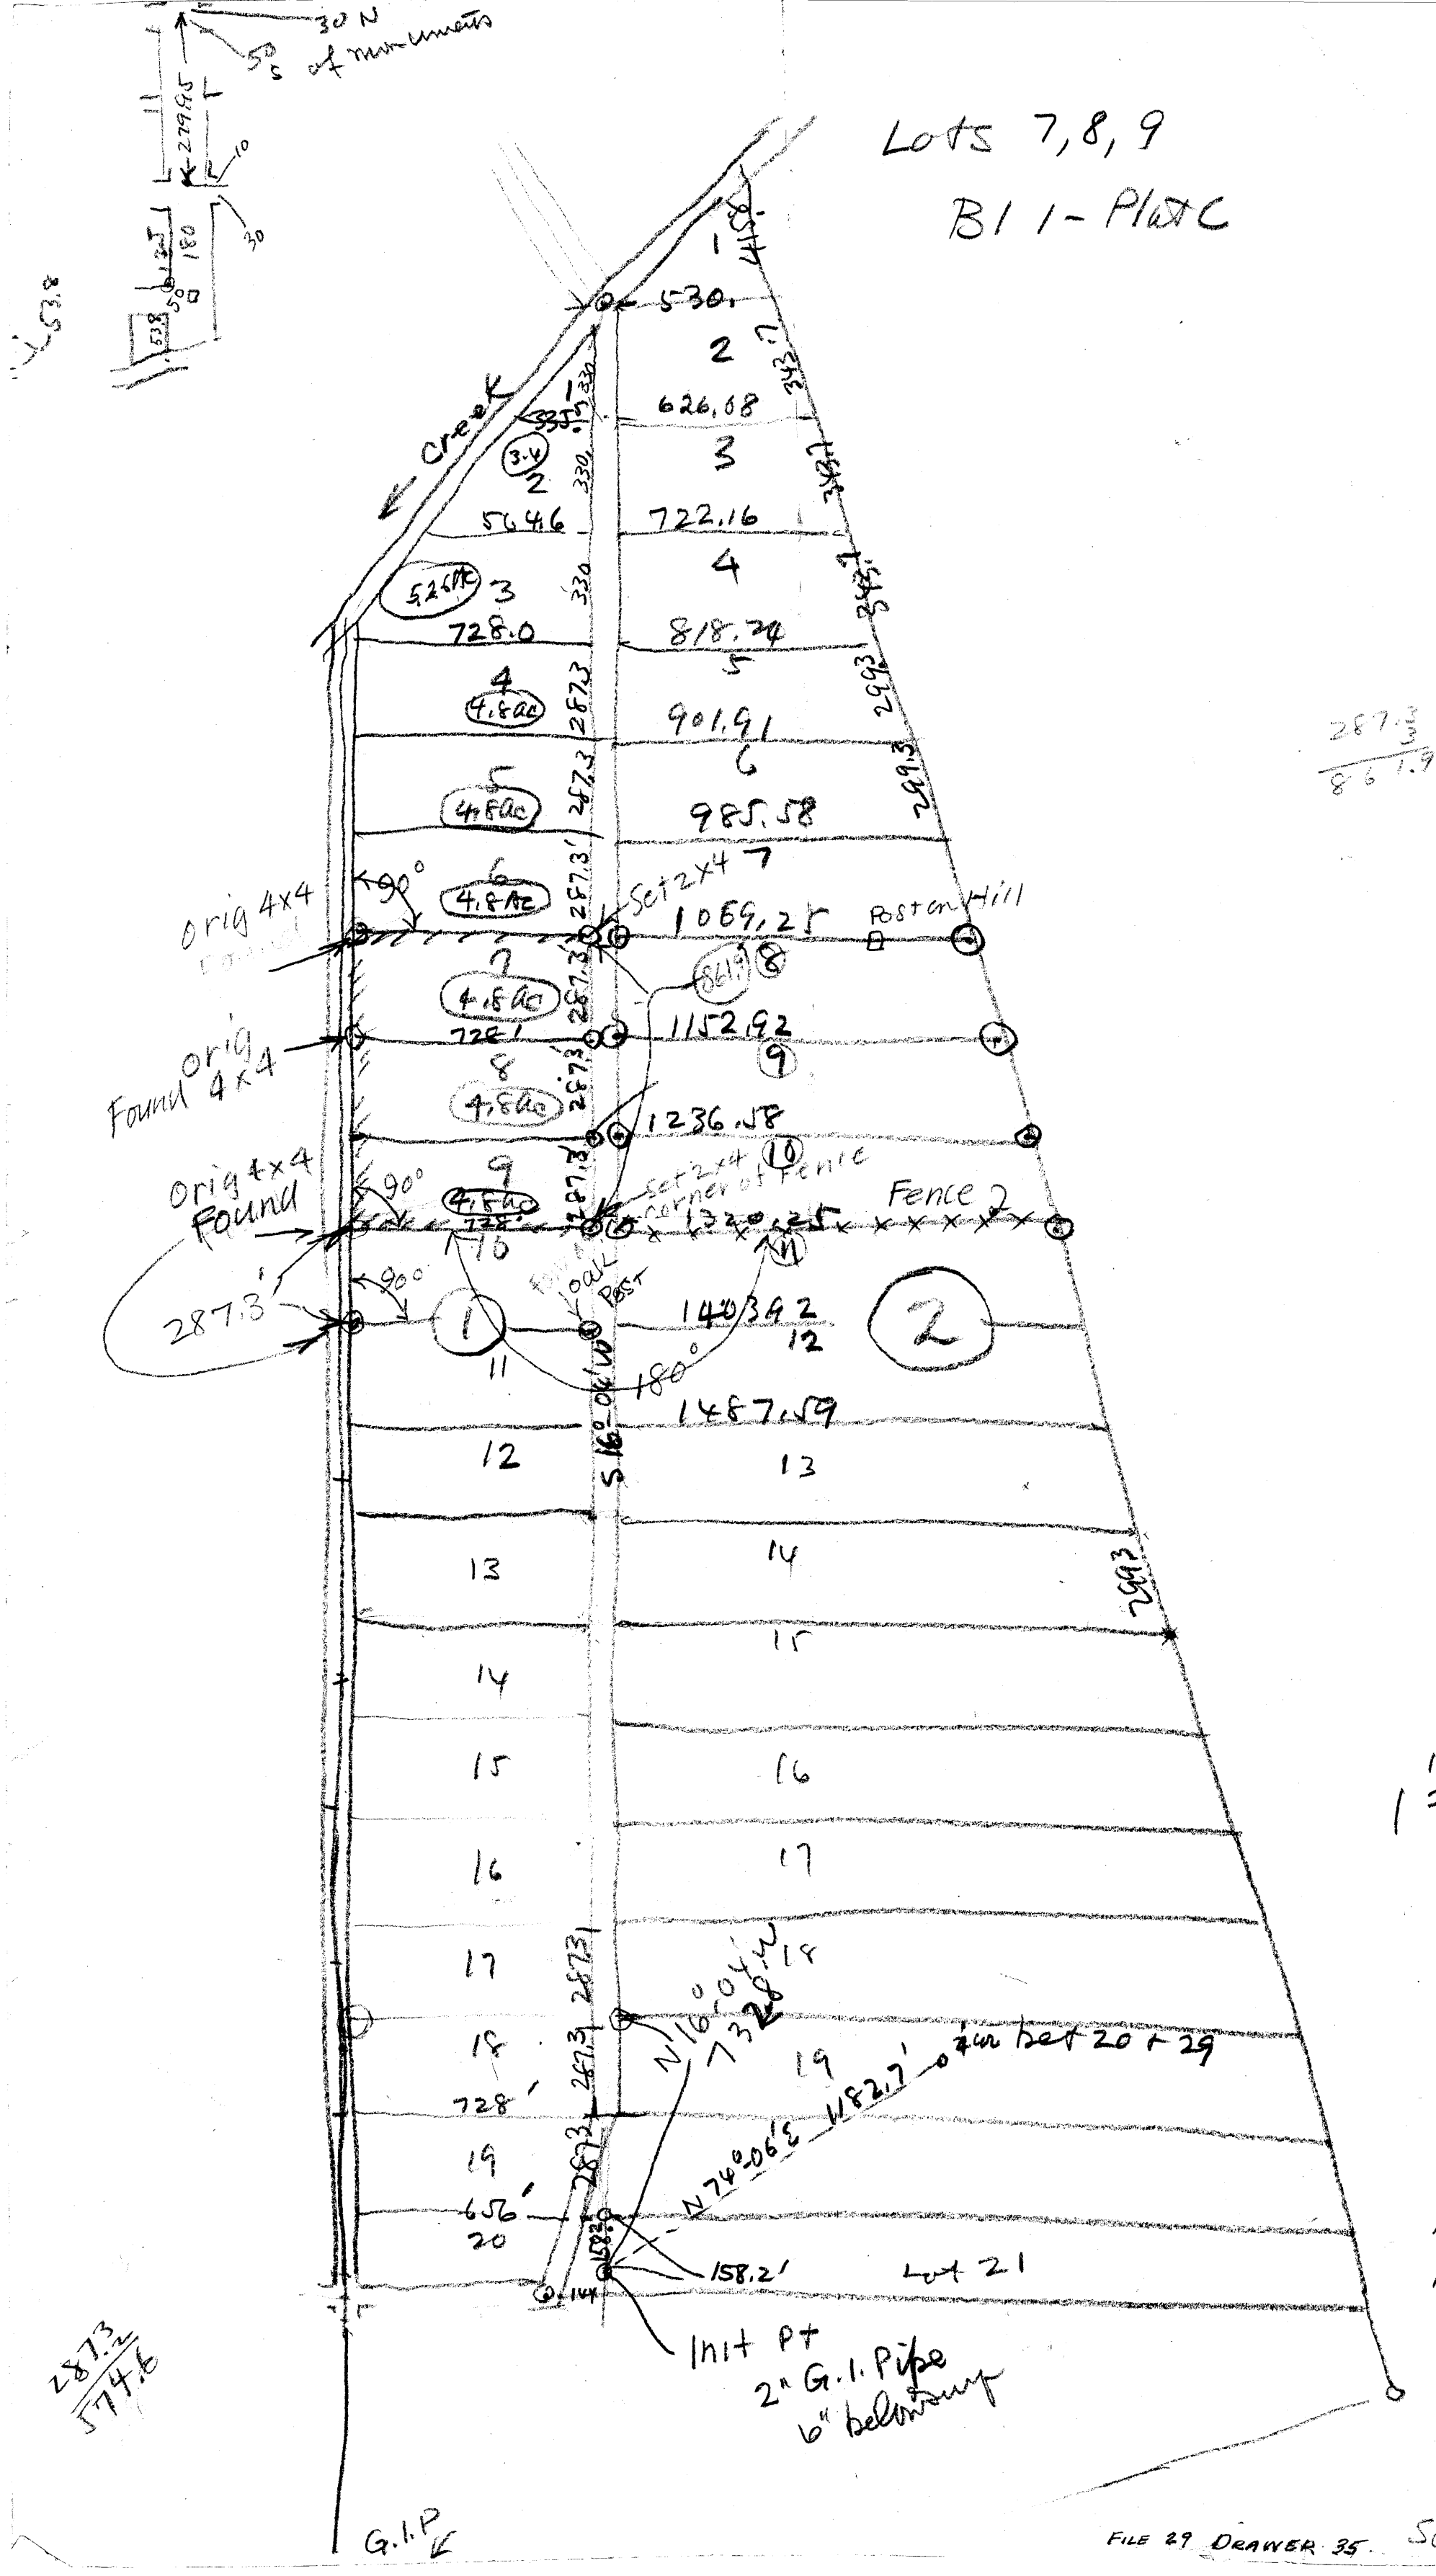
Lots 7, 8, 9
B1 1 - Plat C
30 N
50 S of monuments
creek
Orig 4x4
Found Orig 4x4
Orig 4x4 Found
287.3'
Set 2x4
Post on Hill
Set 2x4 corner of fence
Fence 2
Post
N 16°-04' W
N 74°-06' E
158.2'
Lot 21
Init Pt
2" G.I. Pipe
6" below surf
G.I.P
1" = 400'
Aug. 13, 1941
A Bryan &
Mr Scheman, S.P.
Lots 7 to 10 inc
Block
Plat C
Sutherland
FILE 29 DRAWER 35.