Mrs Churchill

Oct 27
1941
A.B.
Bill Crear

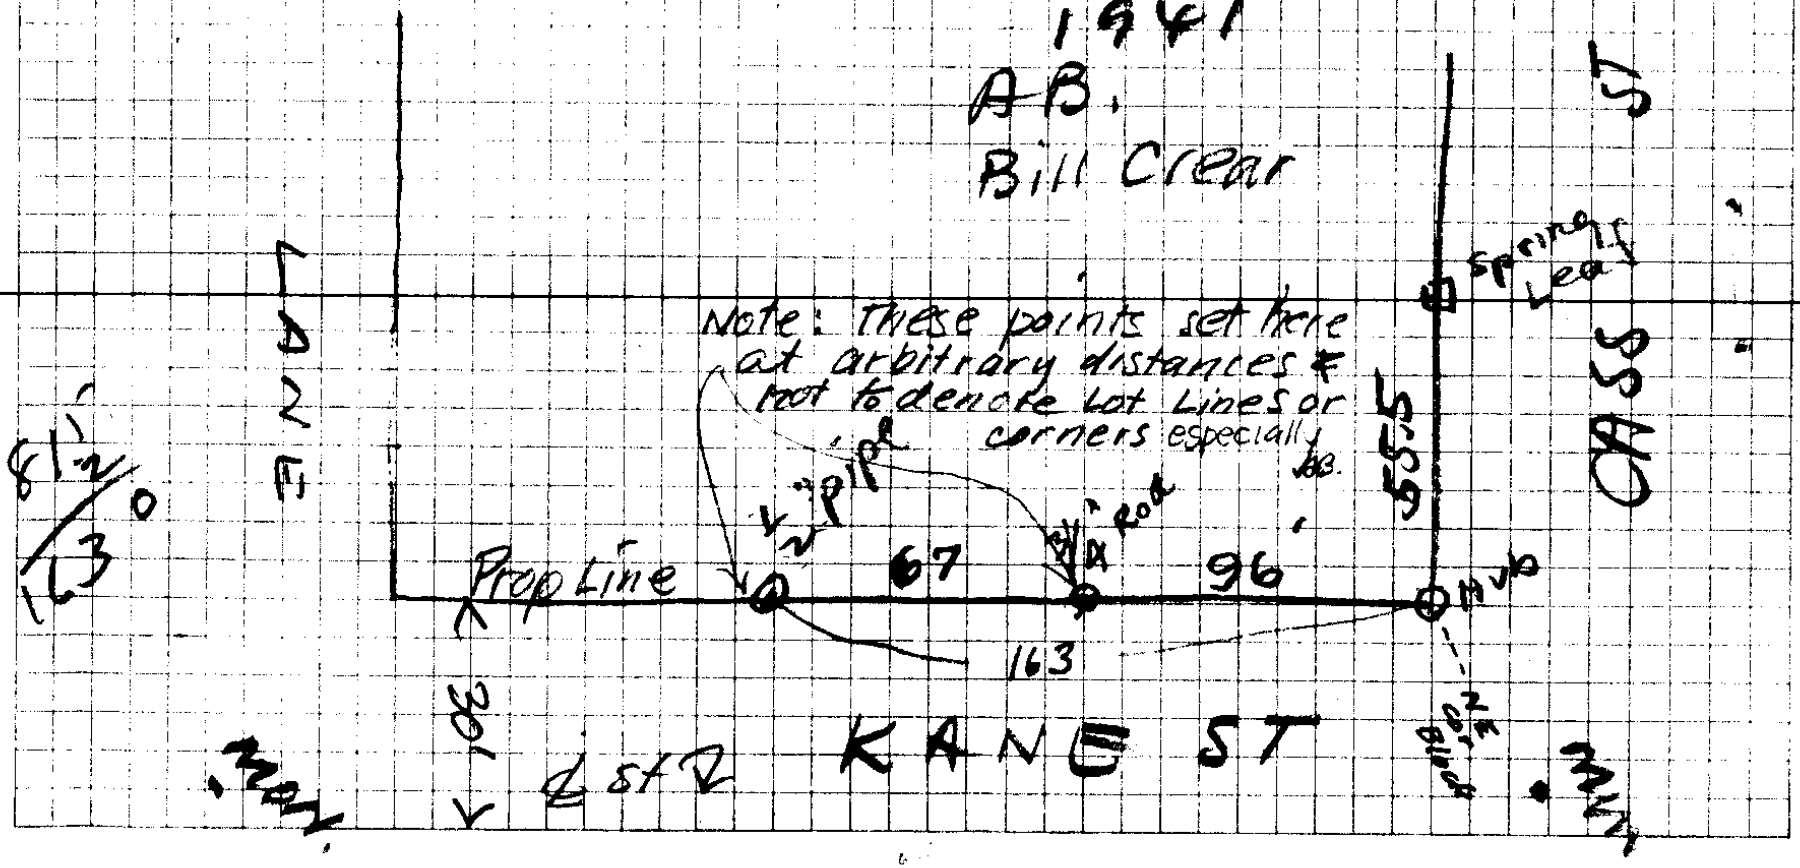

8½/13

C.S. 35/42

35-42