


Mr. O. F. Thiel
Box 312
Yoncalla, Ore

Tp. 23 S. R 4 W.

SEC.
COT.

80.26

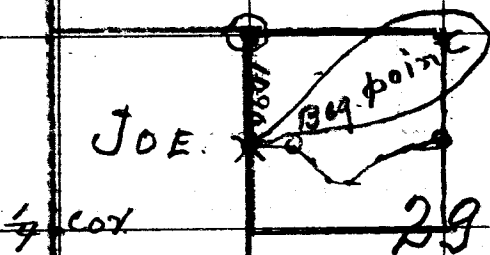

SEC
COT.

79.76

32

CS FILE FOLDER

CONTAINS

MORE

INFORMATION