FILE DRAWER [redacted] V36 E45

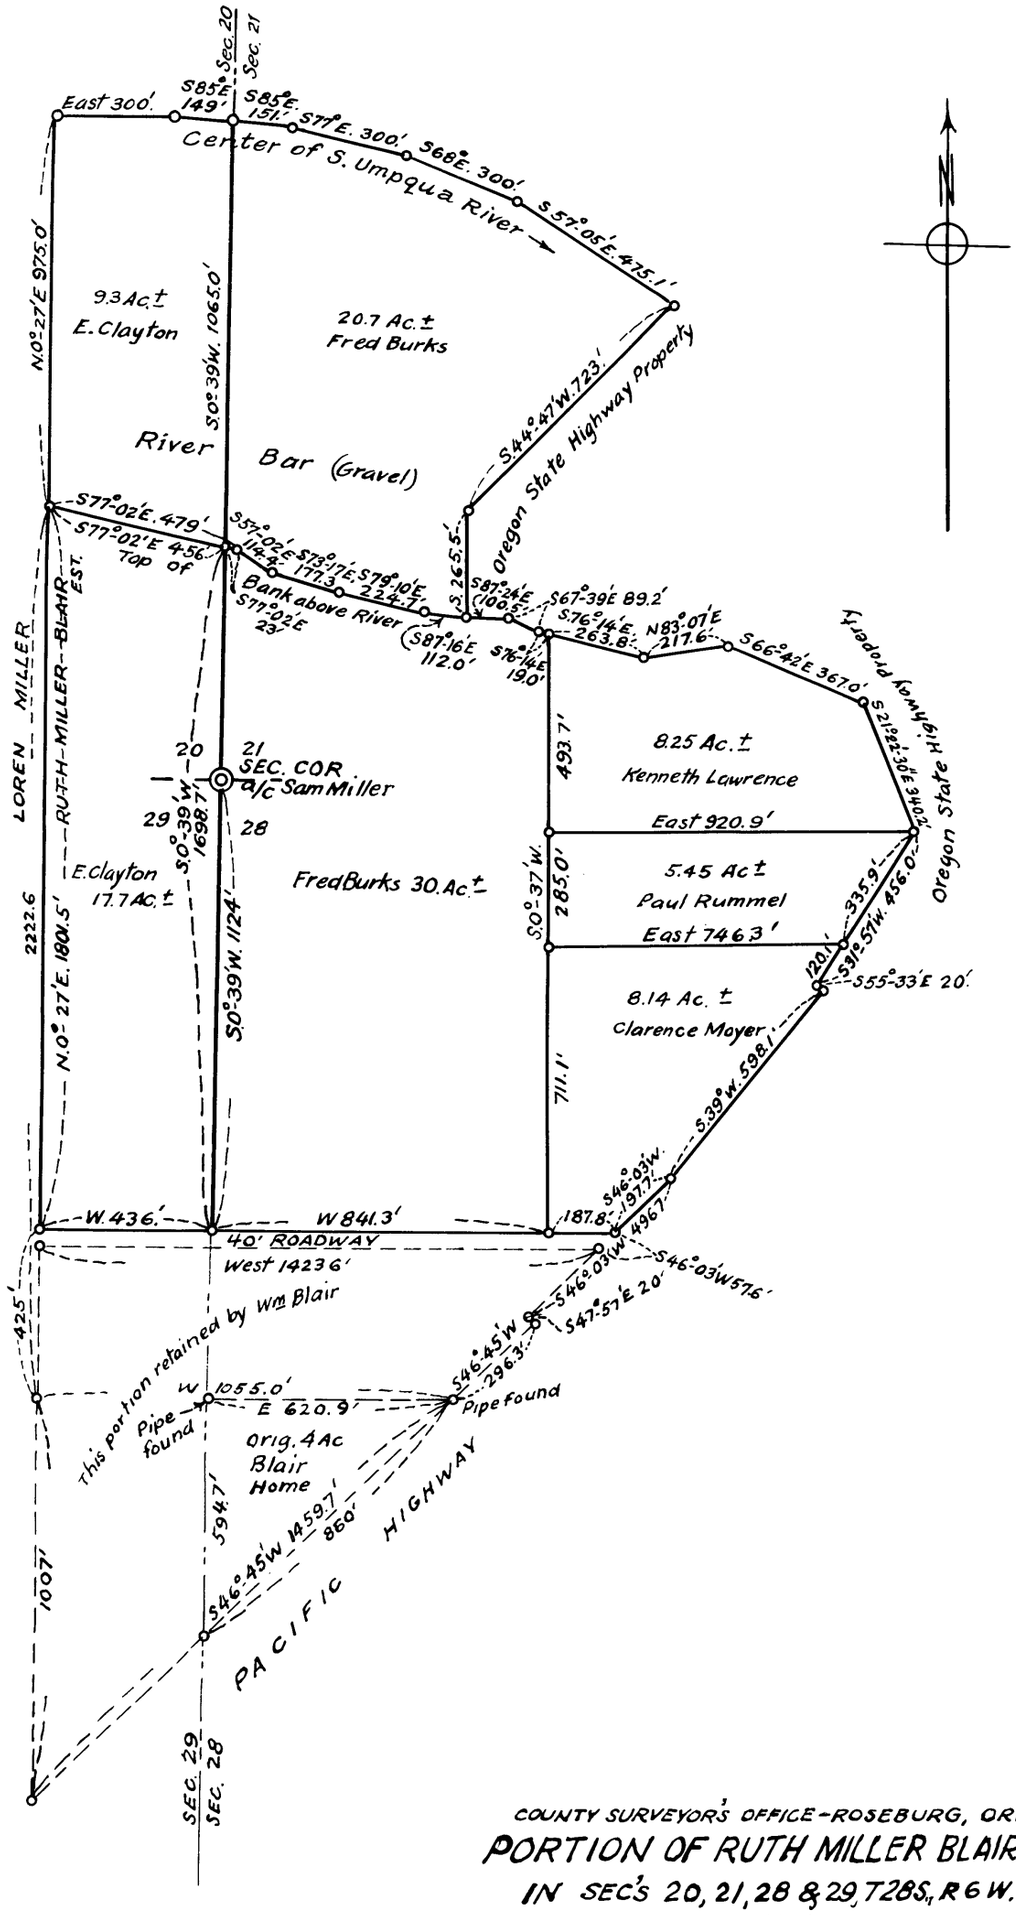

COUNTY SURVEYOR'S OFFICE - ROSEBURG, ORE.

PORTION OF RUTH MILLER BLAIR EST.

IN SEC'S 20, 21, 28 & 29, T28S., R6W. OF WILLAMETTE MERIDIAN; DOUGLAS COUNTY, ORE.

JULY, 1943 A Boyer Dep. Scale 1" = 400 ft.

Survey of Dec '42 - Jan '43.

C.S. Bin No. 36/45

CS FILE FOLDER

CONTAINS

MORE

INFORMATION