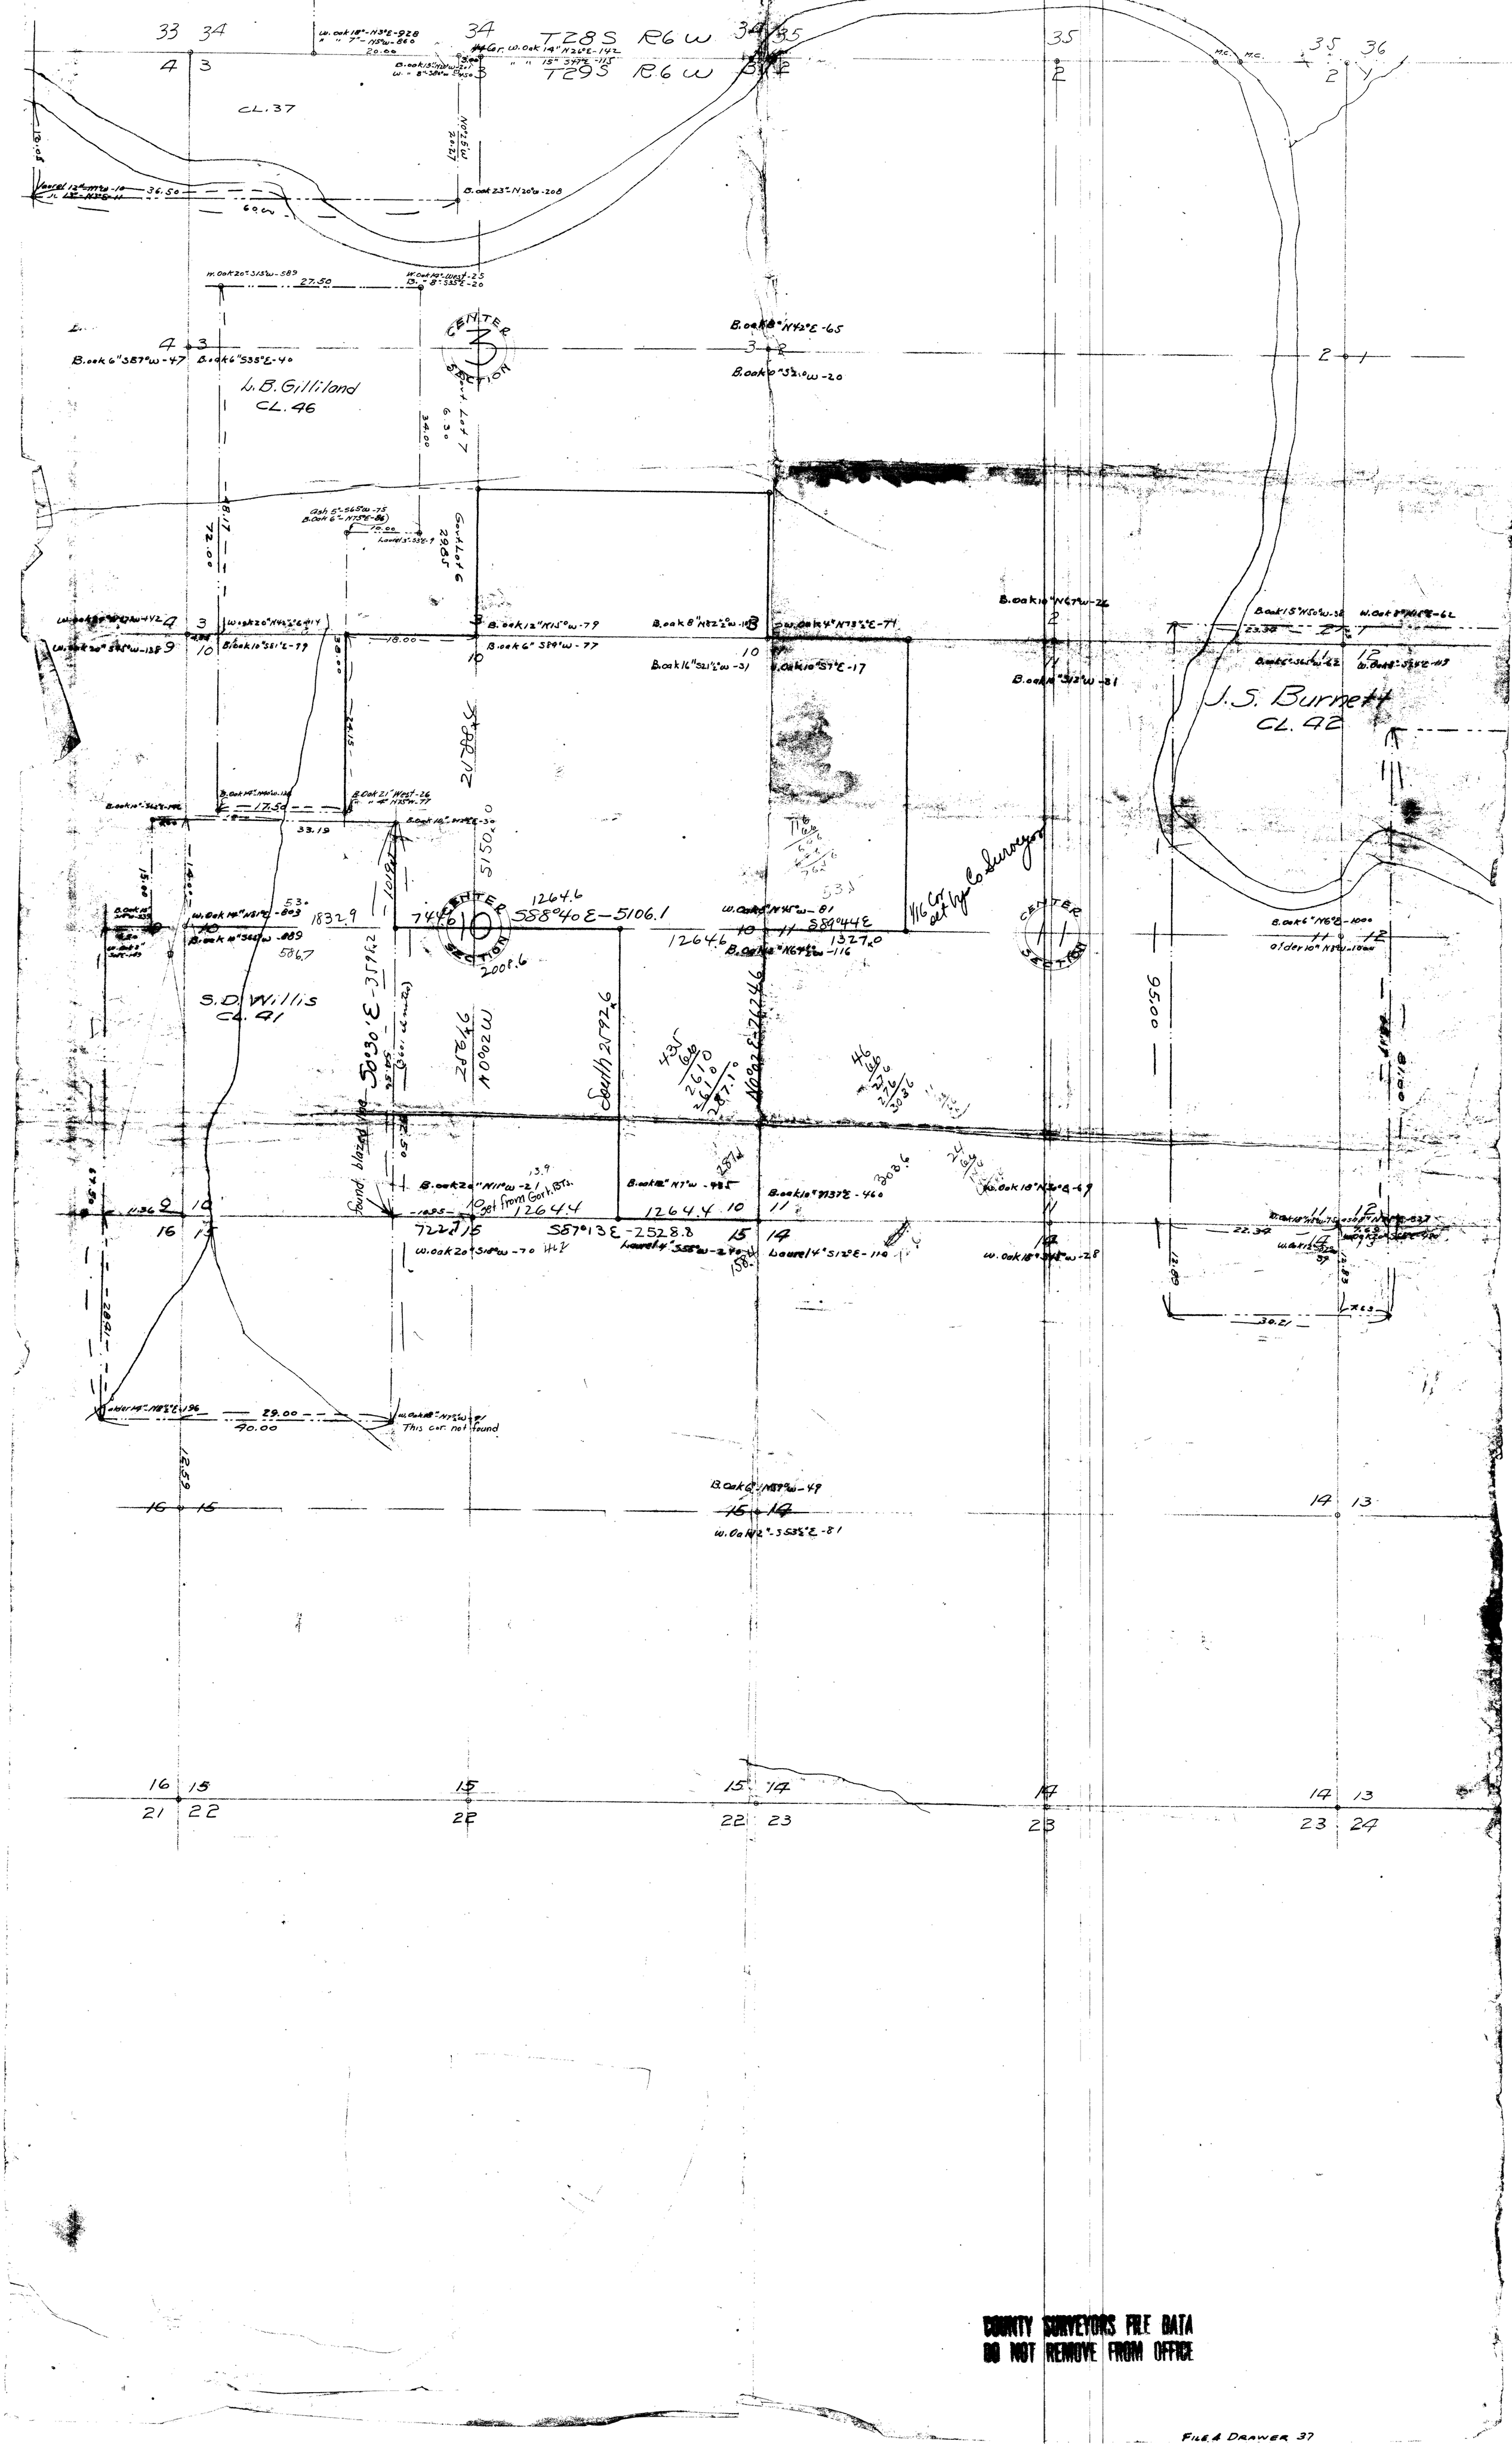
T28S R6W
T29S R6W
CL. 37
L. B. Gilliland
CL. 46
J. S. Burnett
CL. 42
S. D. Willis
CL. 41
CENTER SECTION
Govt. Lot 7
Govt. Lot 6
1/16 Cor. set by Co. Surveyor
This cor. not found
COUNTY SURVEYORS FILE DATA
DO NOT REMOVE FROM OFFICE
FILE 4 DRAWER 37