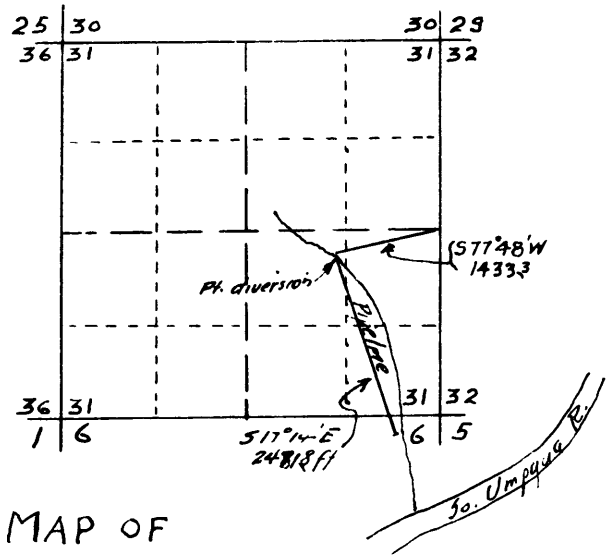

MAP OF
C. Weaver DOMESTIC WATER SUPPLY
IN

SECTION 31 TWP 29S. RANGE 5 W.W.M.

DOUGLAS COUNTY OREGON

OFFICE OF

Ben. B. IRVING

Civil Engineer & Surveyor

CERTIFICATE OF SURVEYOR.

I, Ben. B. Irving of Roseburg, Oregon, do hereby certify that this map was made from notes taken during an actual survey made by me on the 16 day of May 1929 and that it correctly represents the works described in the accompanying application together with the location of streams and other ditches in the immediate vicinity

OREGON No 290

Date of Registration Nov. 8. 1919

Ben B. Irving

Registered Professional Engineer