COUNTY SURVEYORS FILE DATA
DO NOT REMOVE FROM OFFICE

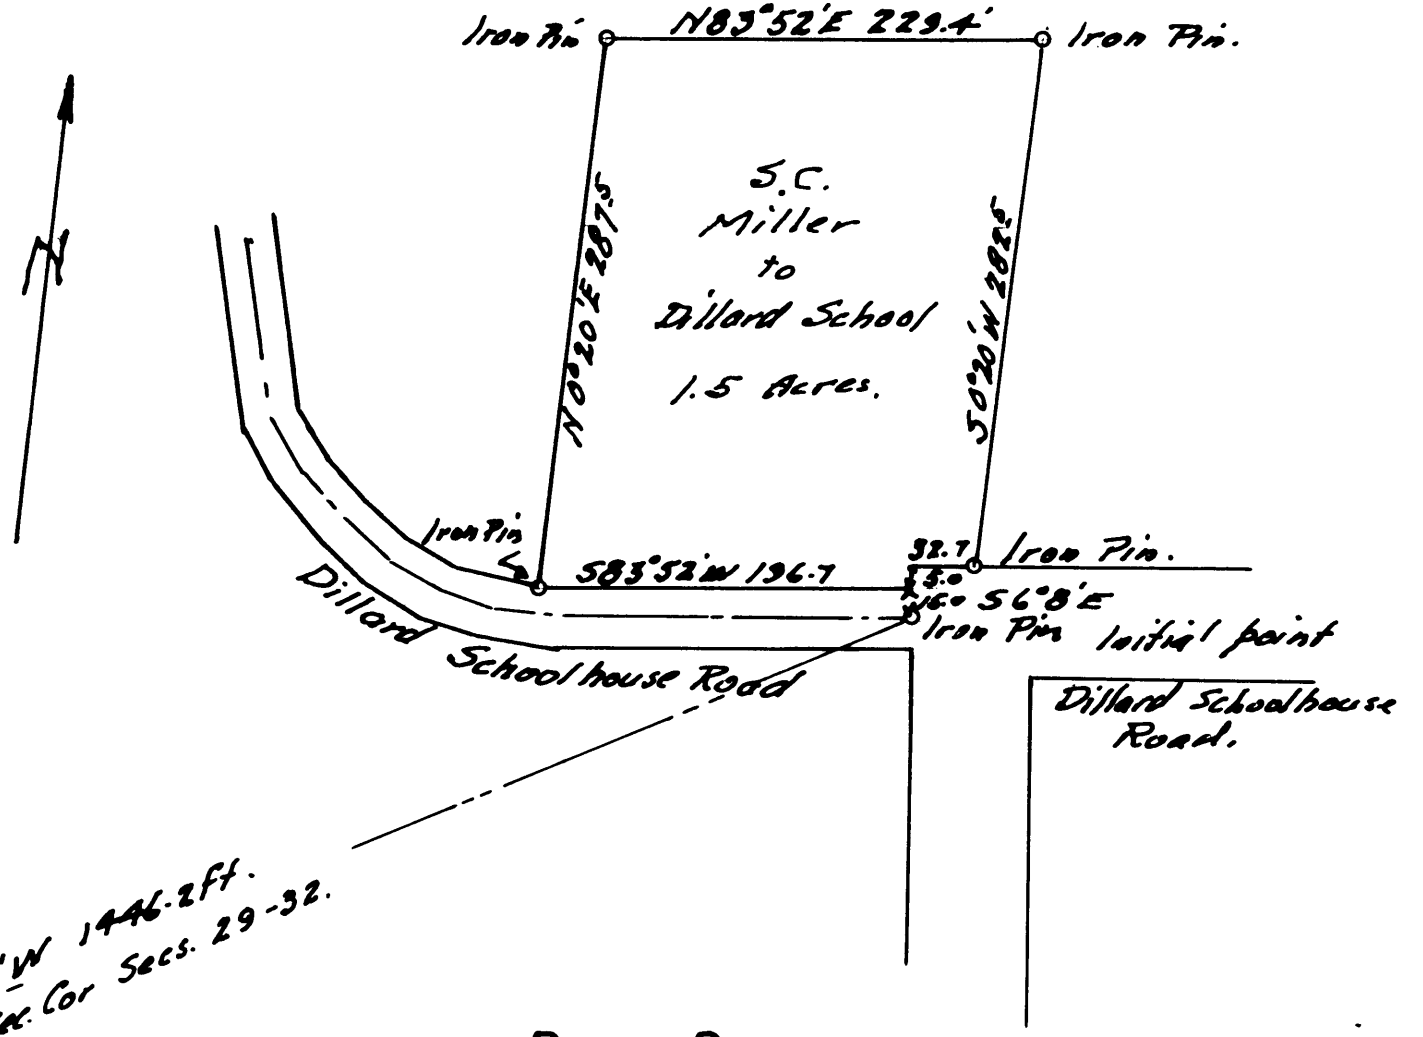

DEED DESCRIPTION
S.C. MILLER TO DILLARD SCHOOL
T. 28S, R 6 W. SEC. 29

surveyed by B.B. Irving Dep. Co. Surveyor
Feb. 15 1932. SCALE 1" = 100'

FILE 63 DRAWER 37