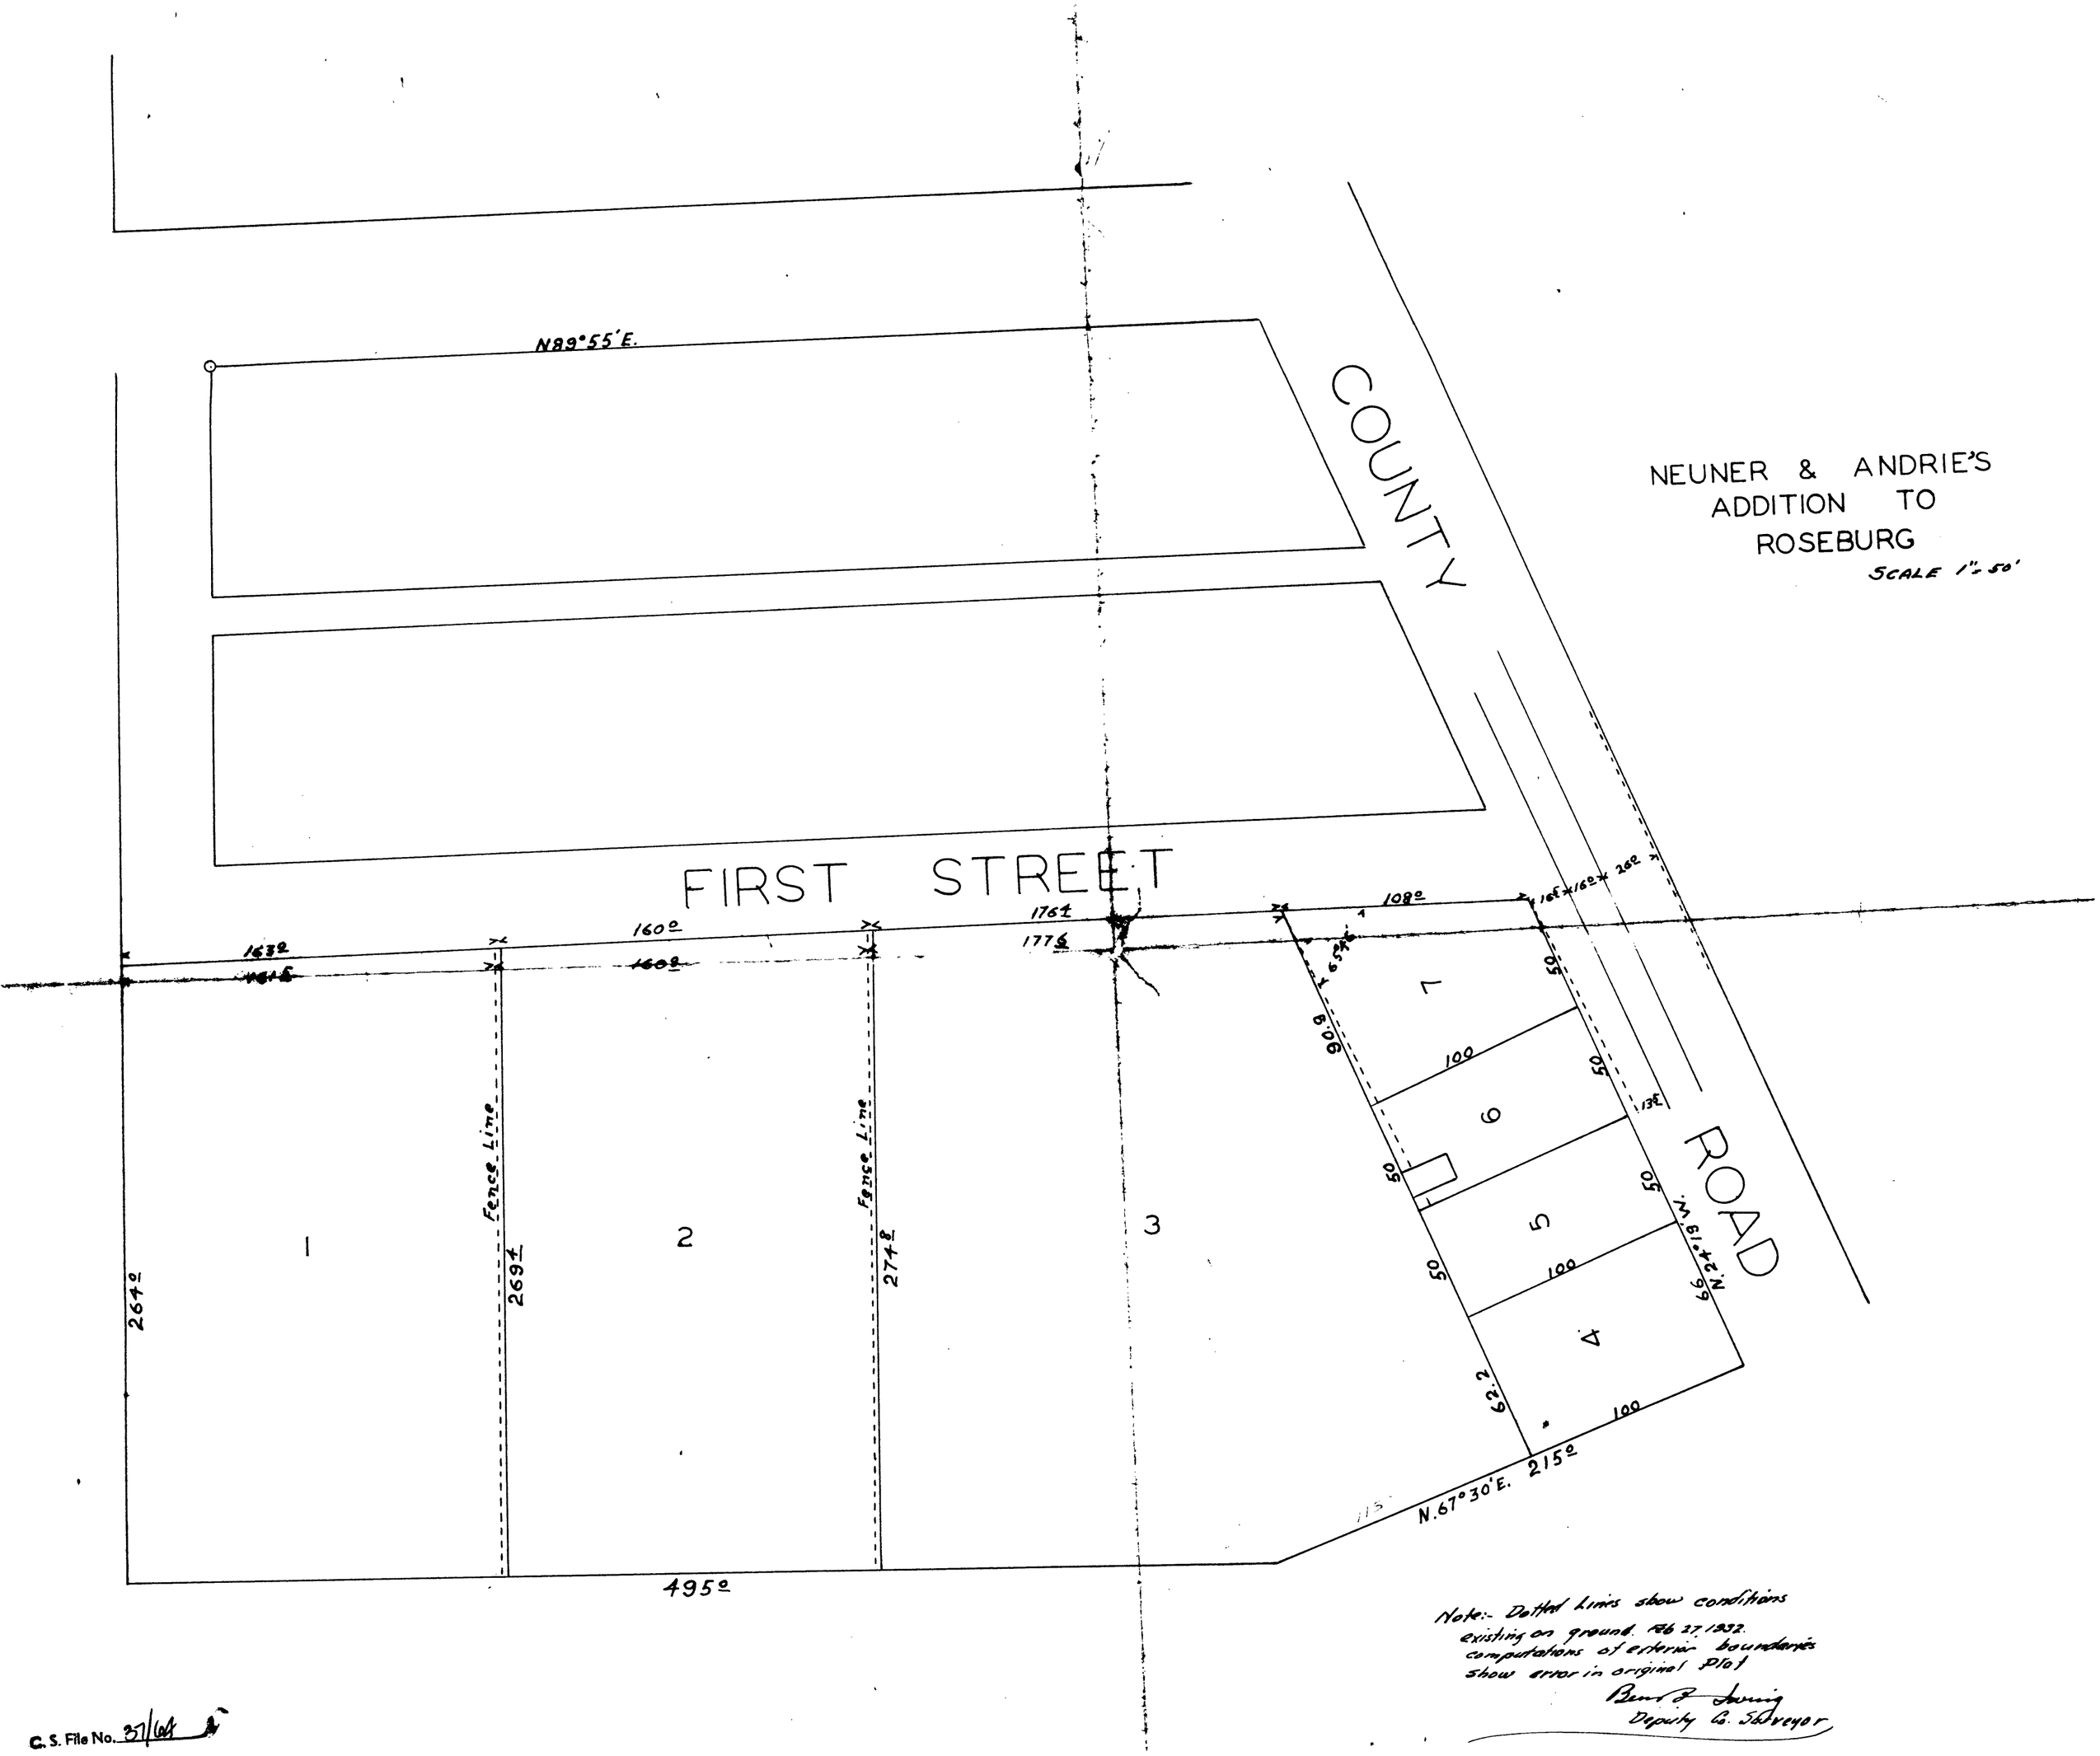

Note:- Dotted lines show conditions existing on ground. Feb 27, 1932. computations of exterior boundaries show error in original plat

Deputy Co. Surveyor

C. S. File No. 37/64