

0.57
5.41

2

101

1" U Iron
24" Oak N15°W 95'

N 27°15' W 1099'

12.23
Acres.


8" Ash Tree

N 60°15' W 516.6'

Auto Spring
10" Oak S35°W 47'

Buckhorn Road to Roseburg

To 1/4 Sec Corner between
secs. 29-30 T 26 S R 3 W 1/4 M
577' 5.5" 1446'
577' 5.5" 1446'

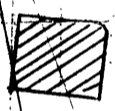

Shrum
House


Bridge

Initial Point

14" Oak S44°33' W 118'
18" " N13°16' E 100'

Road Gilde to Peel
S 61° E 444'

Little River

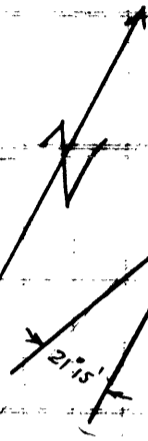

N

up bearing
checked
stad

AREA FOR INVESTIGATION OF WEA

SKETCH SHOWING
12.23 ACRE TRACT
surveyed for
DEN & DOSS
SEC. 30 T 26 S R 3 W 1/4 M
by
Ben B Irving Dep Co. Surv.
Jan 10 1933

Scale 1" = 200'

COUNTY SURVEYORS FILE DATA
DO NOT REMOVE FROM OFFICE

37/53-2

C. E. ...

10000