COUNTY SURVEYORS FILE DATA
DO NOT REMOVE FROM OFFICE

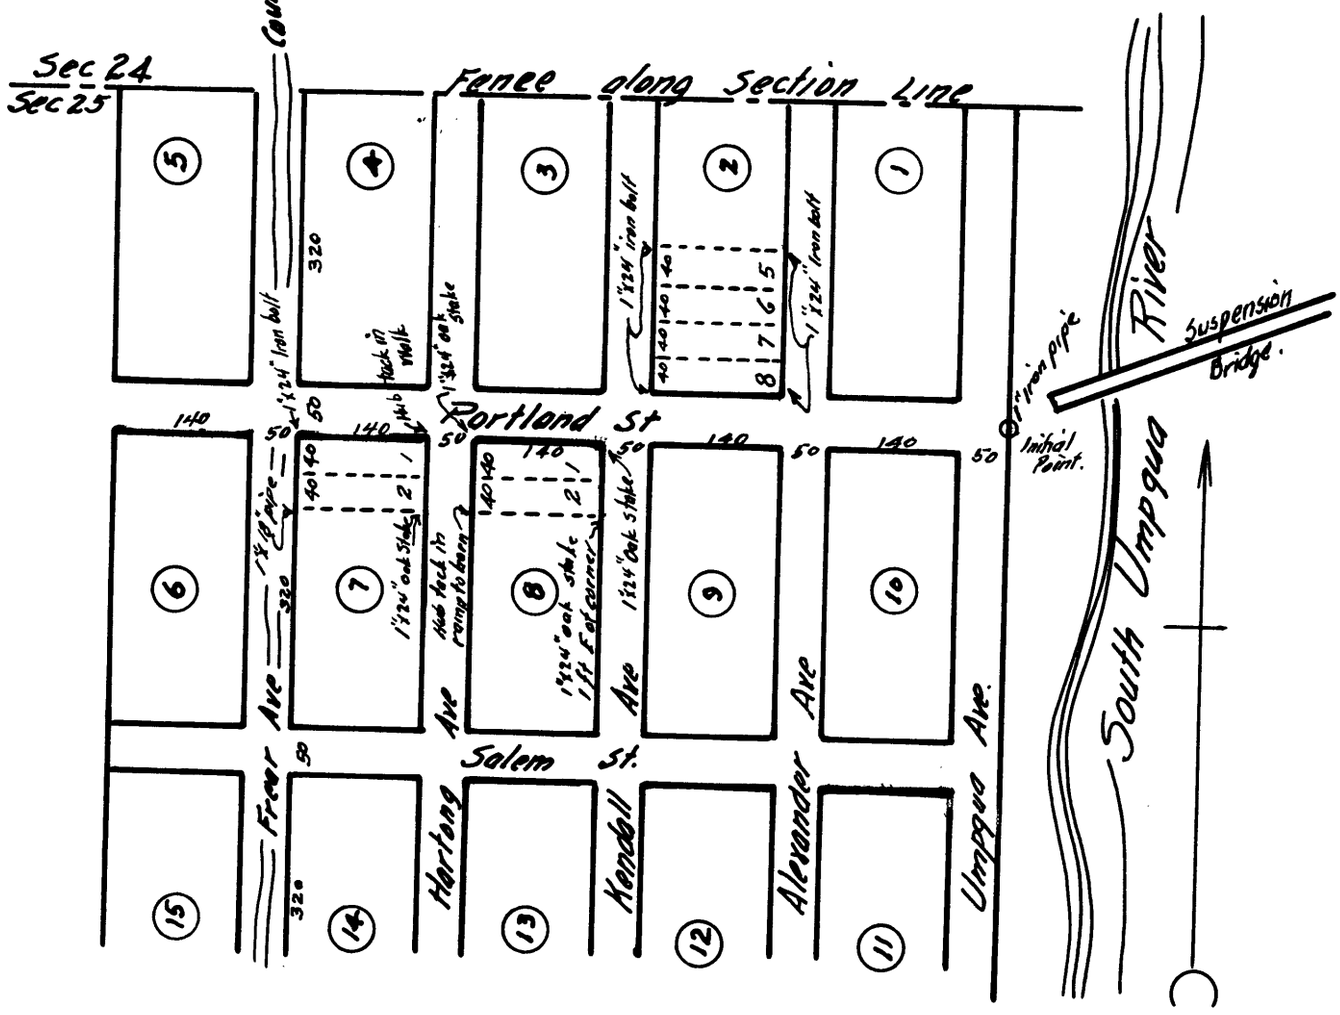

Portion of

UMPQUA PARK

showing

Block 2 Lots 5-6-7-8.

Block 7 Lots 1 & 2.

Block 8 Lots 1 & 2.

Surveyed March 25 1926 } by
Platted " 26 1926 }

Ben B Irving

Ben B Irving

CERTIFICATE OF SURVEYOR.

I, Ben. B. Irving, of Roseburg, Oregon do hereby certify that this map was made from notes taken during an actual survey made by me on the 25th day of March 1926, and that it correctly shows the location described above in T. 27 S. R. 6 W. W.M.

Ben B Irving
Registered Professional Engineer

Dr. 37/P FILE 99 DRAWE