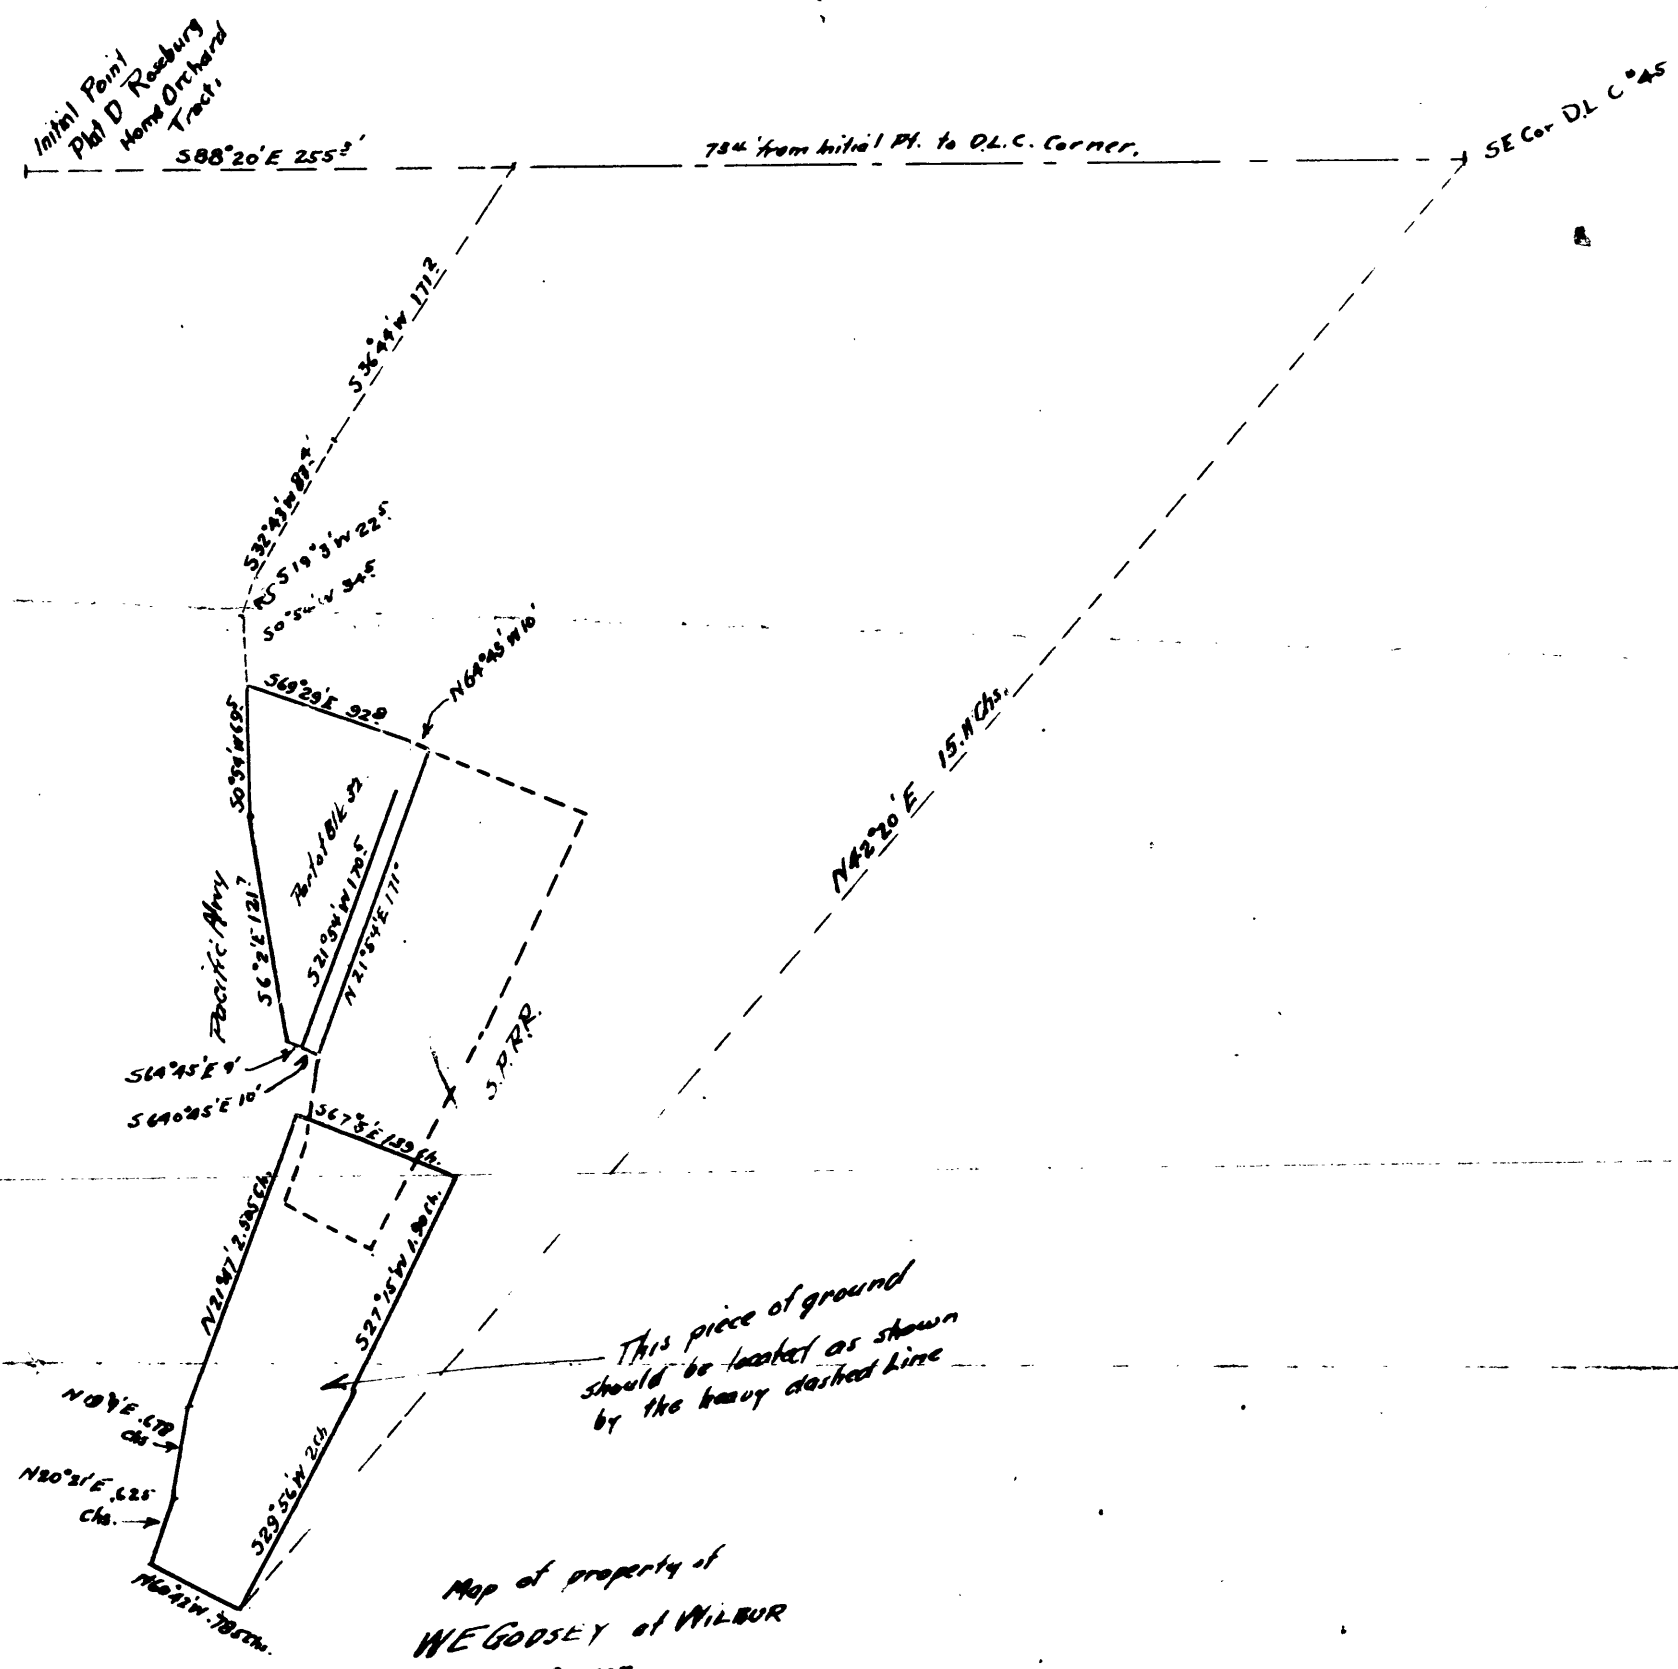

Map of property of
WE GODSEY of WILBUR
Oregon.

Platted from deed description
by B Strong June 28 1926

160'