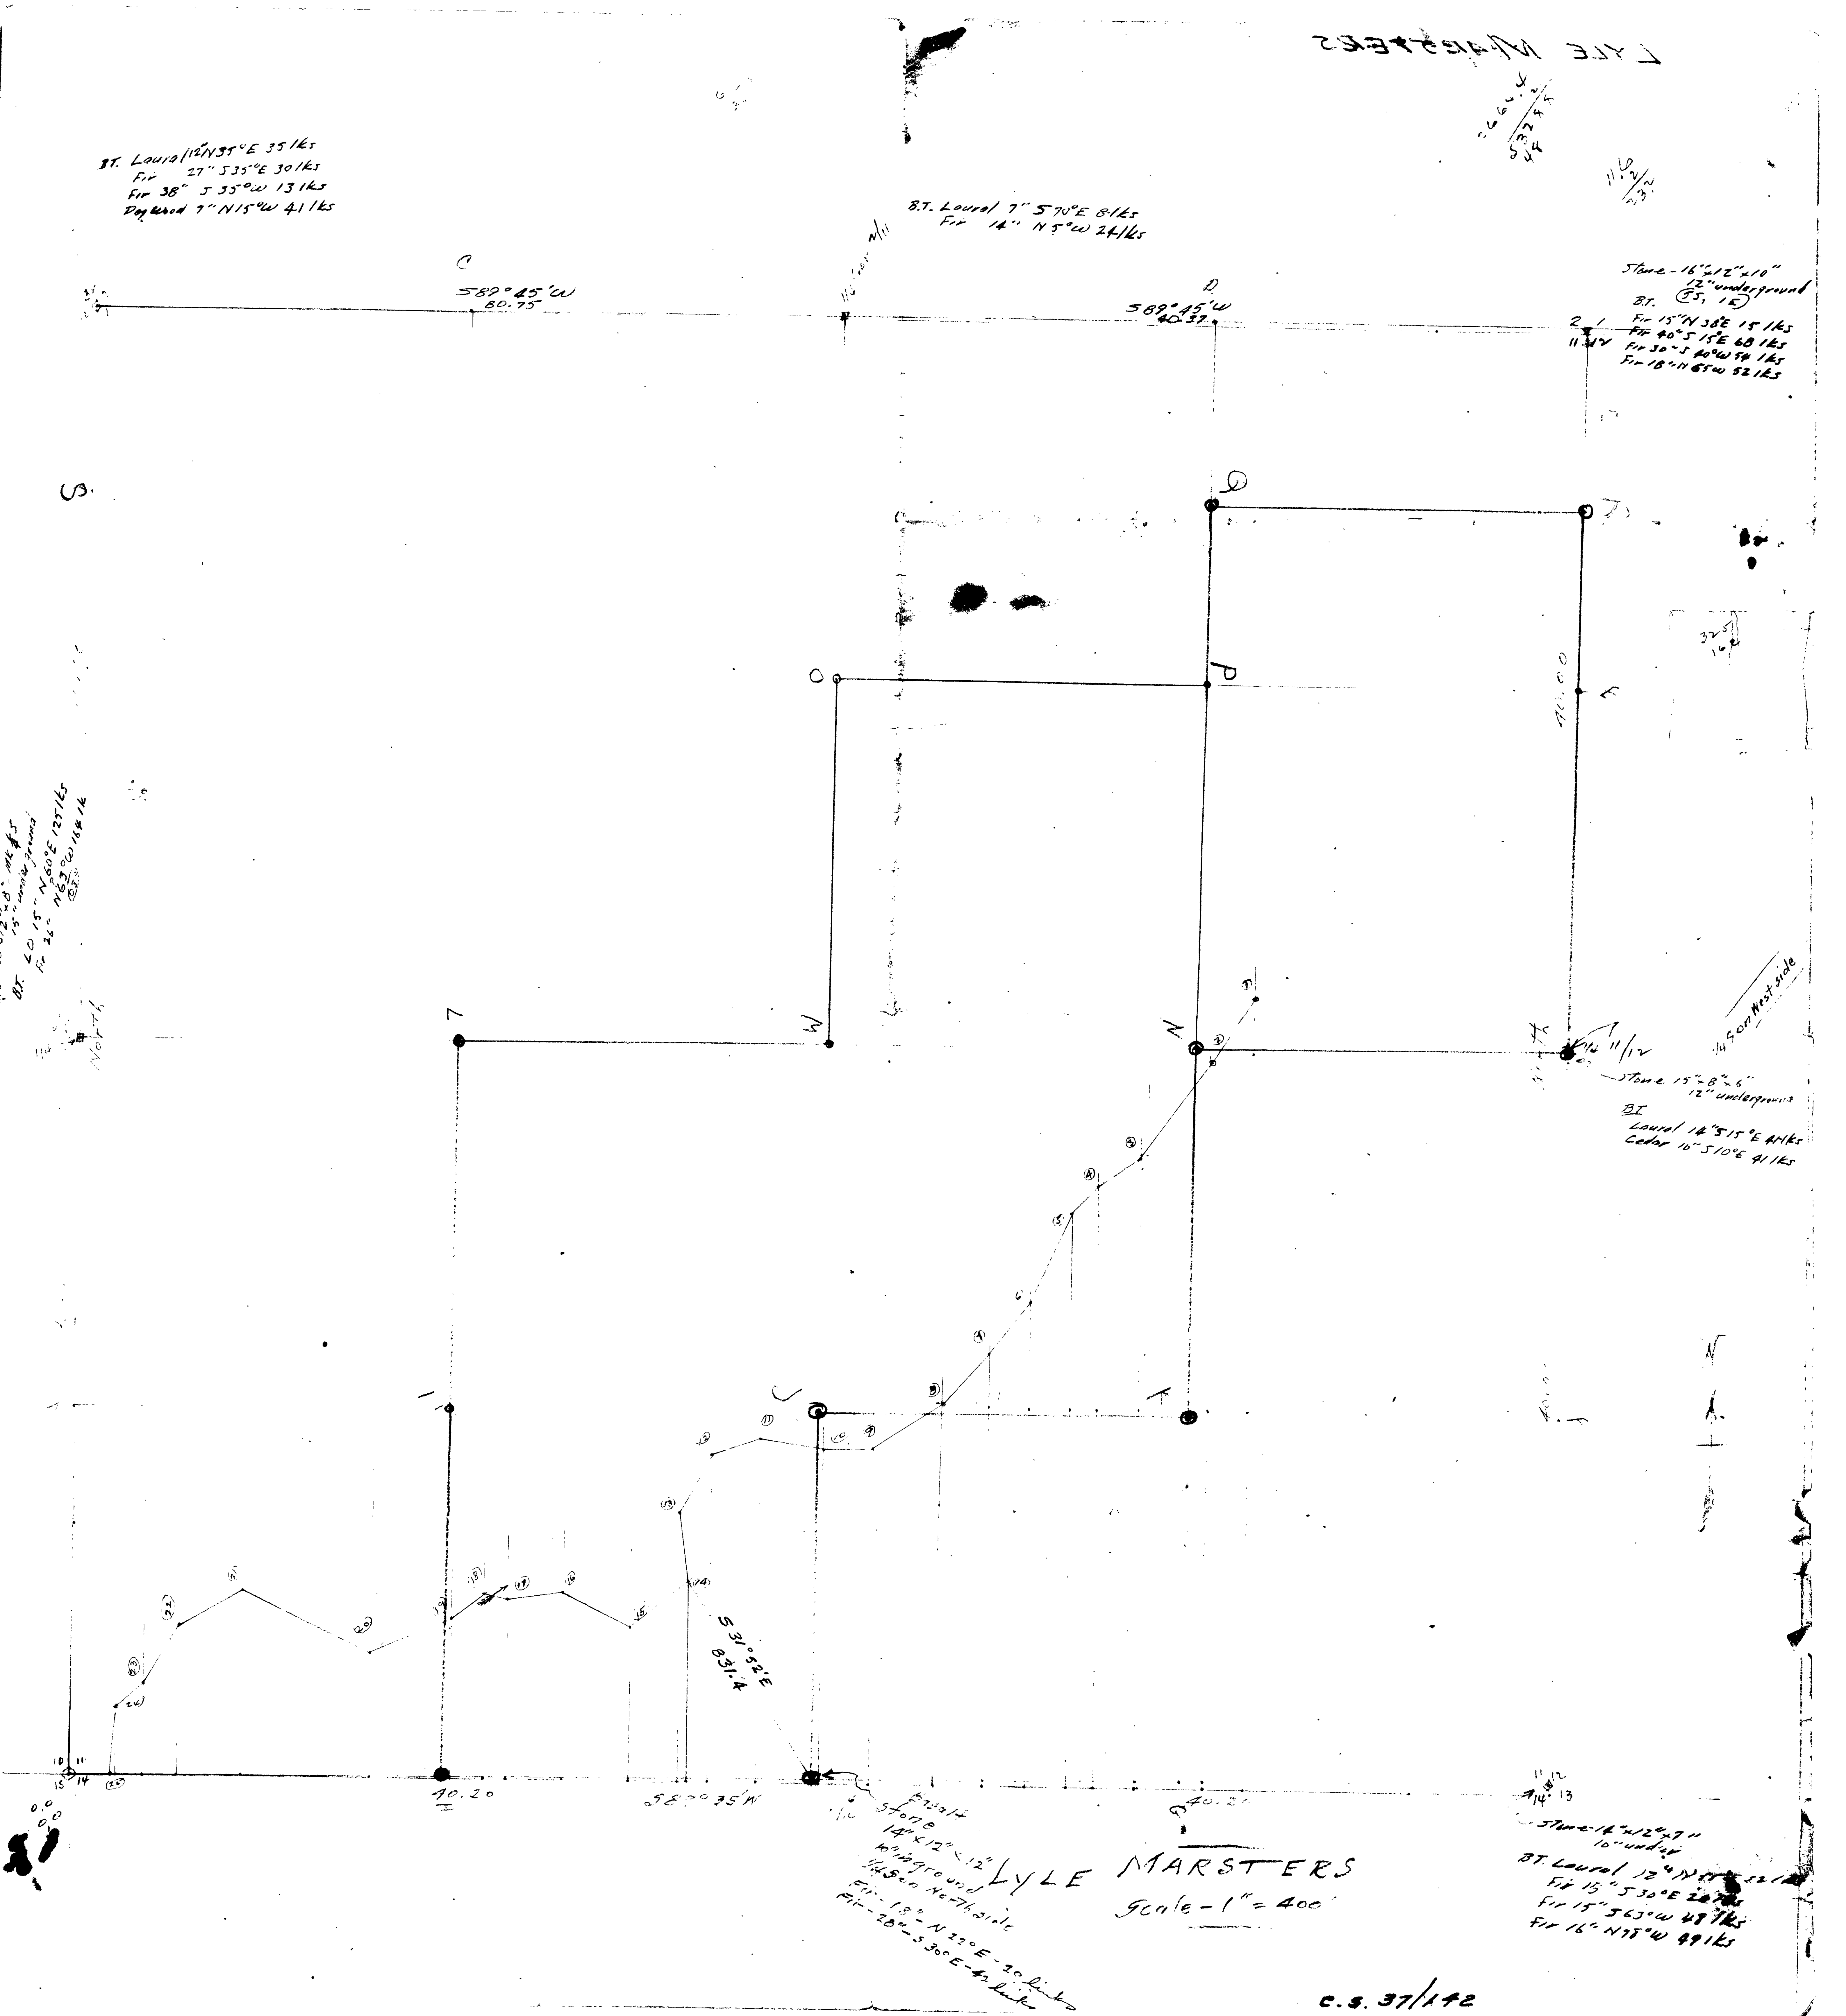

B.T. Loura 12" N35°E 35 lks
Fir 27" S35°E 30 lks
Fir 38" S35°W 13 lks
Dogwood 7" N15°W 41 lks
C
S89°45'W
80.75
B.T. Laurel 7" S70°E 8 lks
Fir 14" N5°W 24 lks
D
S89°45'W
40.37
Stone - 16"x12"x10"
12" underground
B.T.
Fir 15" N38°E 15 lks
Fir 40" S15°E 68 lks
Fir 30" S40°W 54 lks
Fir 18" N65W 52 lks
O
P
Q
E
W
N
Stone 15"x8"x6"
12" underground
BT
Laurel 14" S15°E 41 lks
Cedar 10" S10°E 41 lks
1/4 S on West side
BT. LO 15" N60°E 125 lks
Fir 26" N63°W 164 lk
15" underground
North
J
S31°52'E
831.4
40.20
S89°35'W
40.20
Basalt
Stone
14"x12"x12"
10" in ground
1/4 S on North side
Fir - 18" - N22°E - 20 links
Fir - 28" - S30°E - 42 links
Stone-16"x12"x7"
10" under
BT. Laurel 12"
Fir 15" S30°E
Fir 15" S63°W 48 lks
Fir 16" N75°W 49 lks
LYLE MARSTERS
Scale - 1" = 400
C.S. 37/142