


Harry Winston

10/10/43

NE, Richardson
H. K. Epstein

(ORIG IN
CS 5/19)

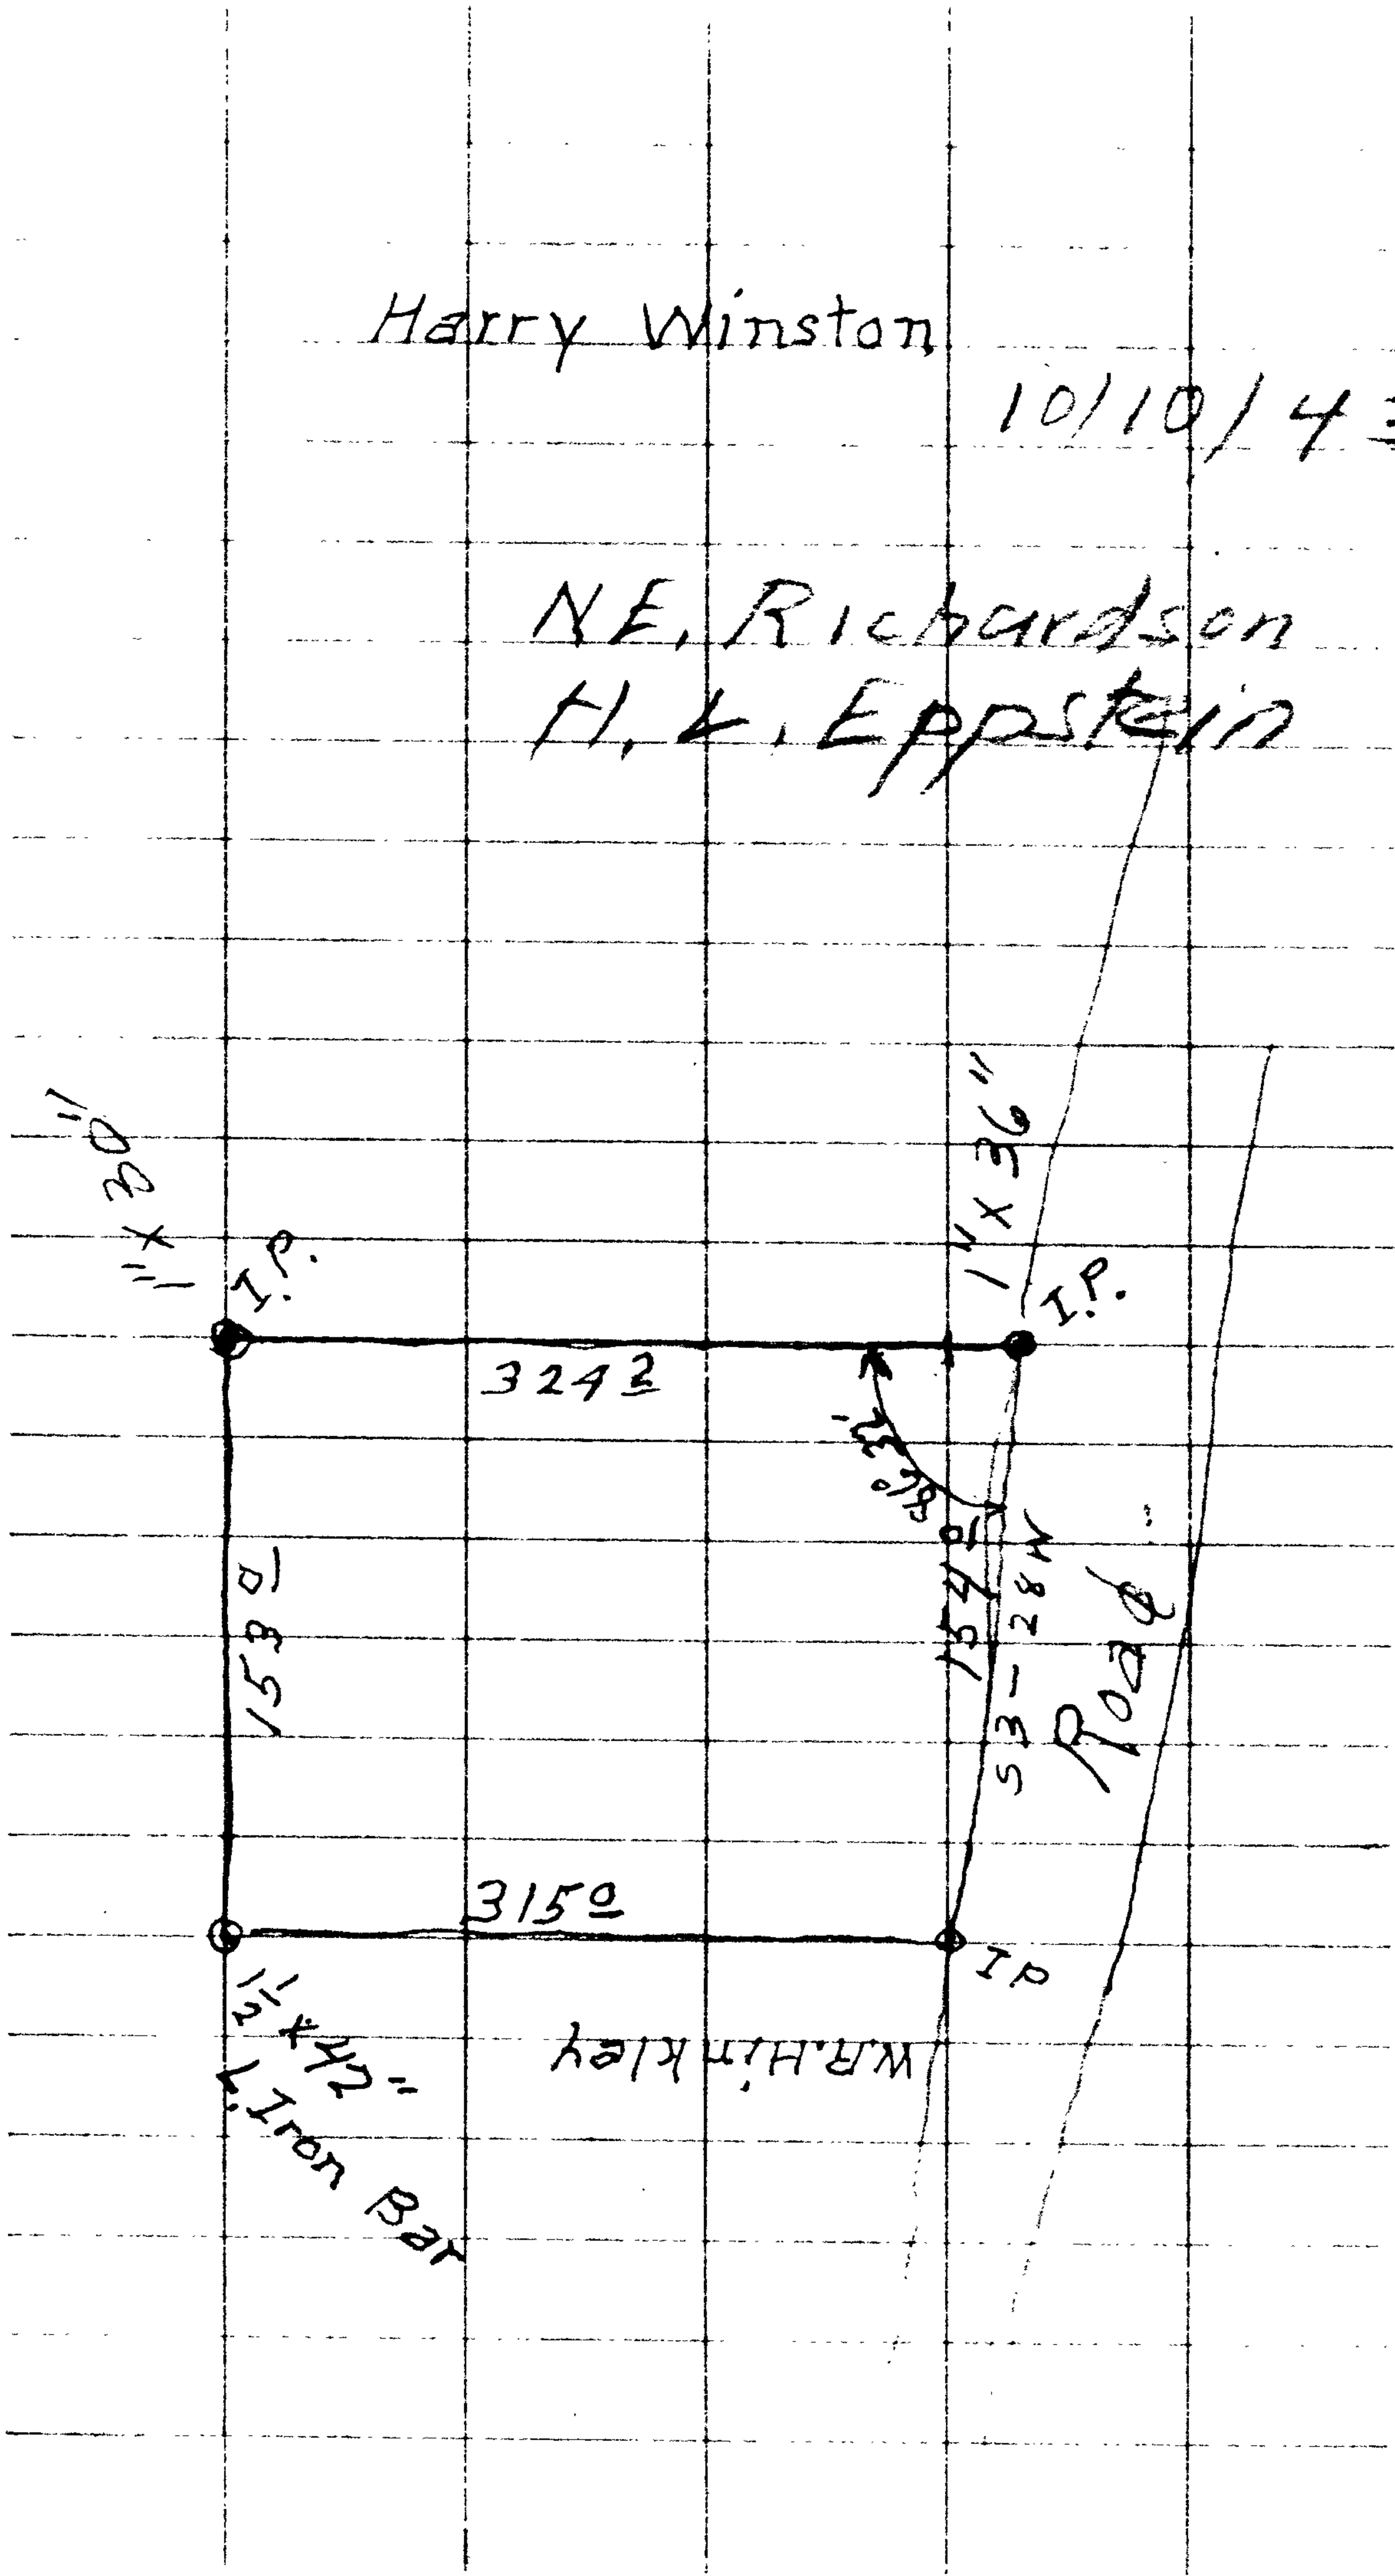

CS 37/154