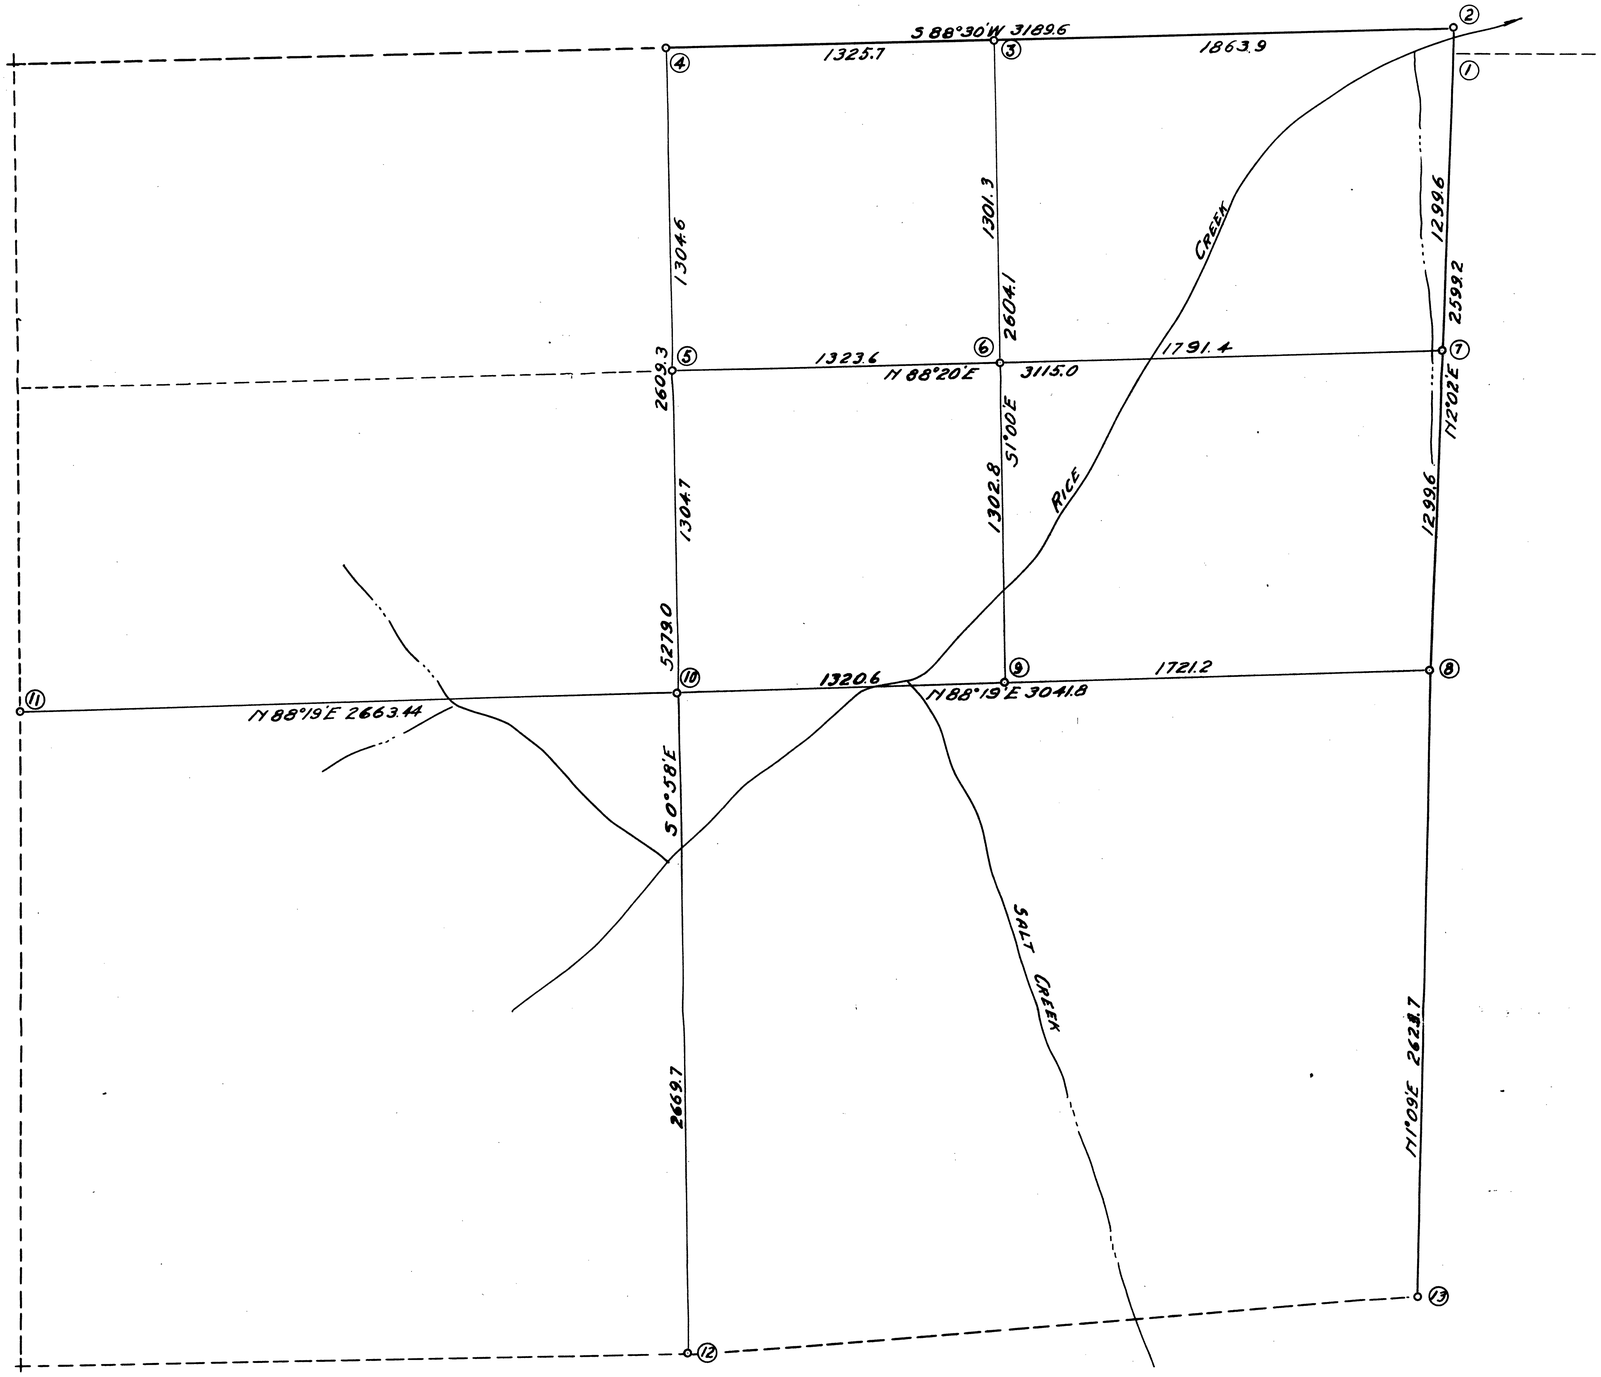

Cor. No	Corner	Description
1	H.W. Sec. 30	Yew Wood Anchor Post for Fence.
2	NE Sec. 25	Stone 15"x12"x8"- Fir Stump N82°W 161 lks.
3	E 1/16 S 24-25	4"x4"x36" Post. Fir N43½°W 35.2 ft. Fir S61½°E 25.6 ft.
4	1/4 S 24-25	4"x4"x36" Post. 12" Fir N59°30'E 47 lks. 14" Fir S67°45'W 61 lks.
5	C.H. 1/16 S 25	4"x4"x36" Post 48" Fir S50°E 24.7 ft. 48" Fir N17°W 5.8 ft.
6	NE 1/16 S 25	8"x12"x18" Stone. 48" Fir S18½°W 18.8 ft 8" Fir N 3½°W 23.0 ft
7	N 1/16 S 25-30	4"x4"x36" Post. 20" Fir S75½°W 18.6 ft 14" Fir N28°E 38 ft.
8	1/4 S 25-30	16"x12"x6" Rock. 14" Fir S60°E 18 lks. 36" Fir S78°W 23 lks.
9	C.E. 1/16 S 25	4"x4"x36" Yew Post. 24" Fir S11°75'W 44.3 ft. Fir N57°30'W 12.2 ft.
10	C 1/4 S 25	4"x4"x36" Yew Post. 24" Fir N48°E 26.1 ft. 10" Fir S4°E 28.3 ft.
11	1/4 S 25-26	4"x4"x36" Post 30" Fir S61°E 93 lks. 18" Fir S63°30'W 39 lks.
12	1/4 S 25-36	4"x4"x36" Post 18" Madrona S40°W 28 lks. 30" Fir N80°E 13 lks.
13	Sec. Cor 25-36-30-31	4"x4"x36" Post 10" Laurel N33°E 36 lks. 16" " S54°E 59 lks 16" " S15°W 40 lks. 8" " N49°W 29 lks.

MAP SHOWING
PARTIAL SUB-DIVISION OF
SEC. 25 T29S.R7W. WM.

SURVEYED BY
BEN. B. IRVING, DEPUTY COUNTY SURVEYOR
MAY 1934

SCALE 1" = 300'

37/121

MAP FILE M1 ... 22