Glenn Fox Water Right
John Sutton Days Creek

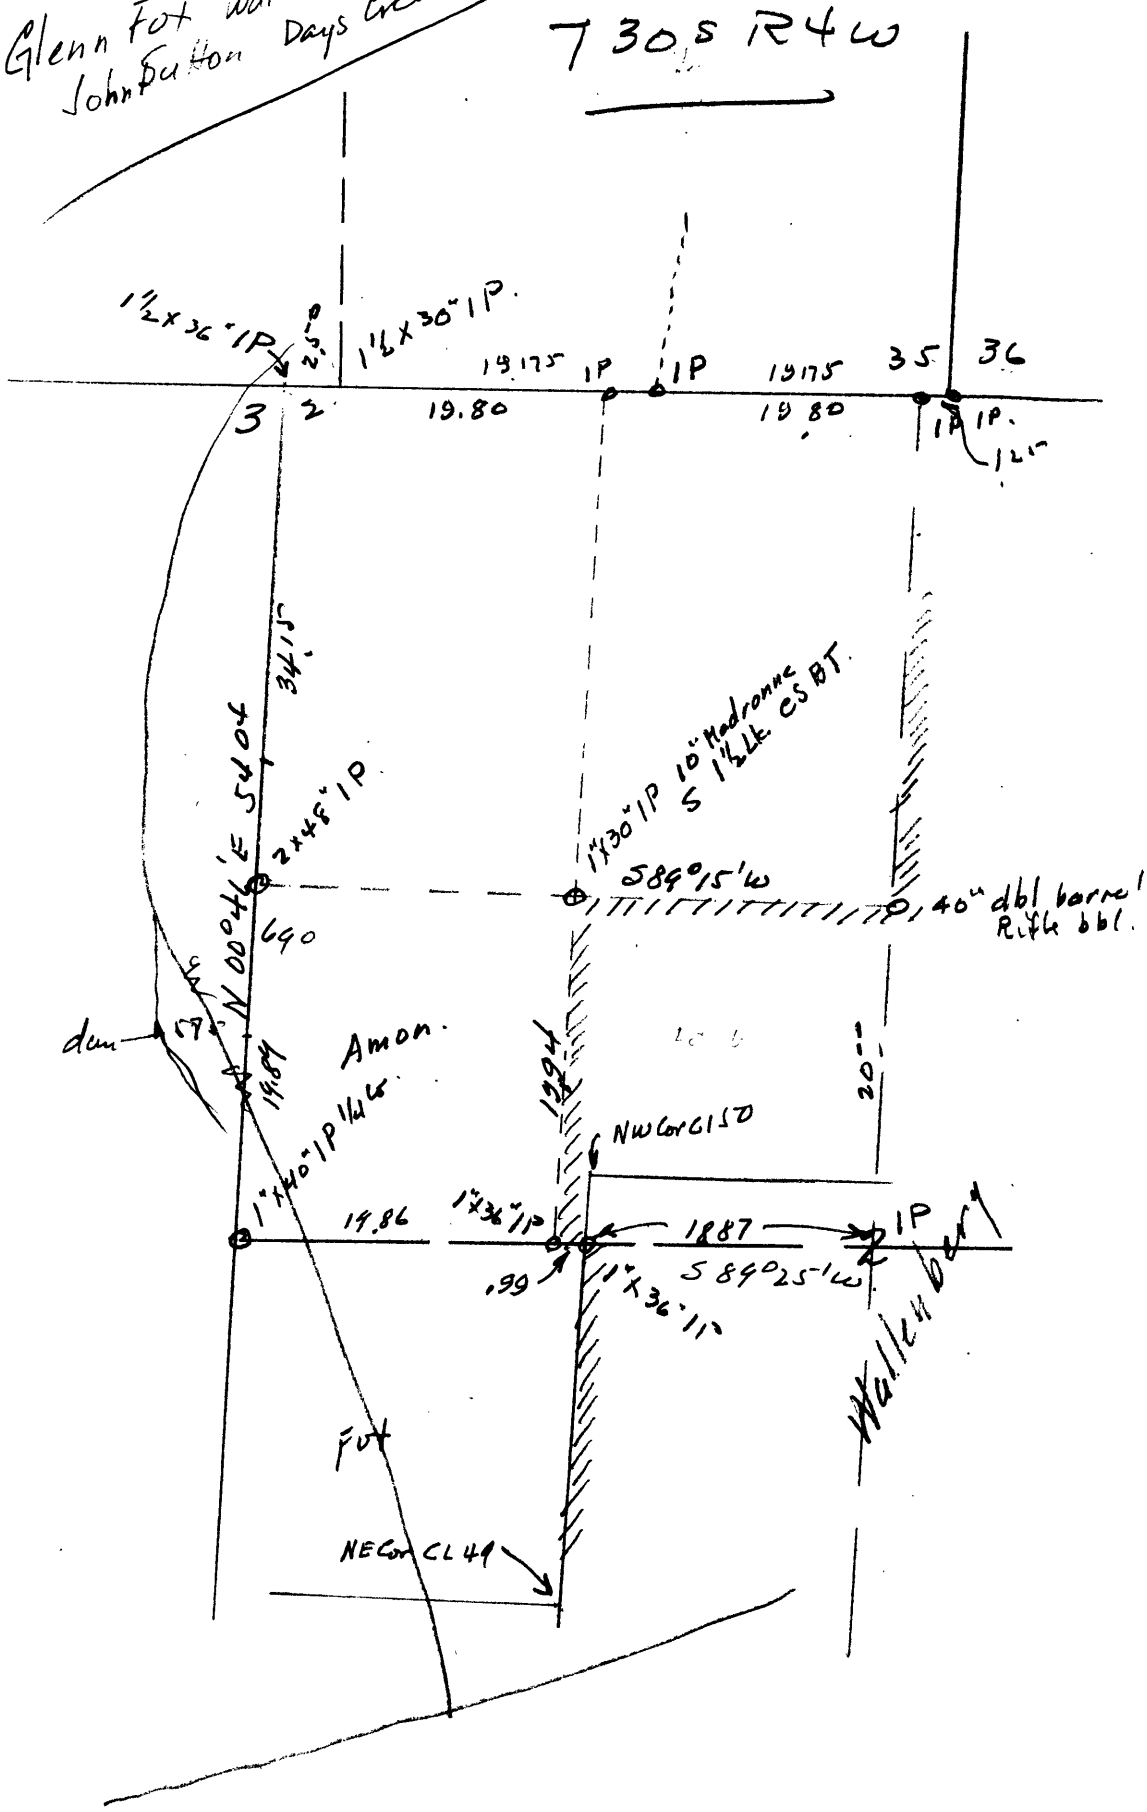

FILE 175 DRAWER 37