COUNTY SURVEYORS FILE DATA
DO NOT REMOVE FROM OFFICE

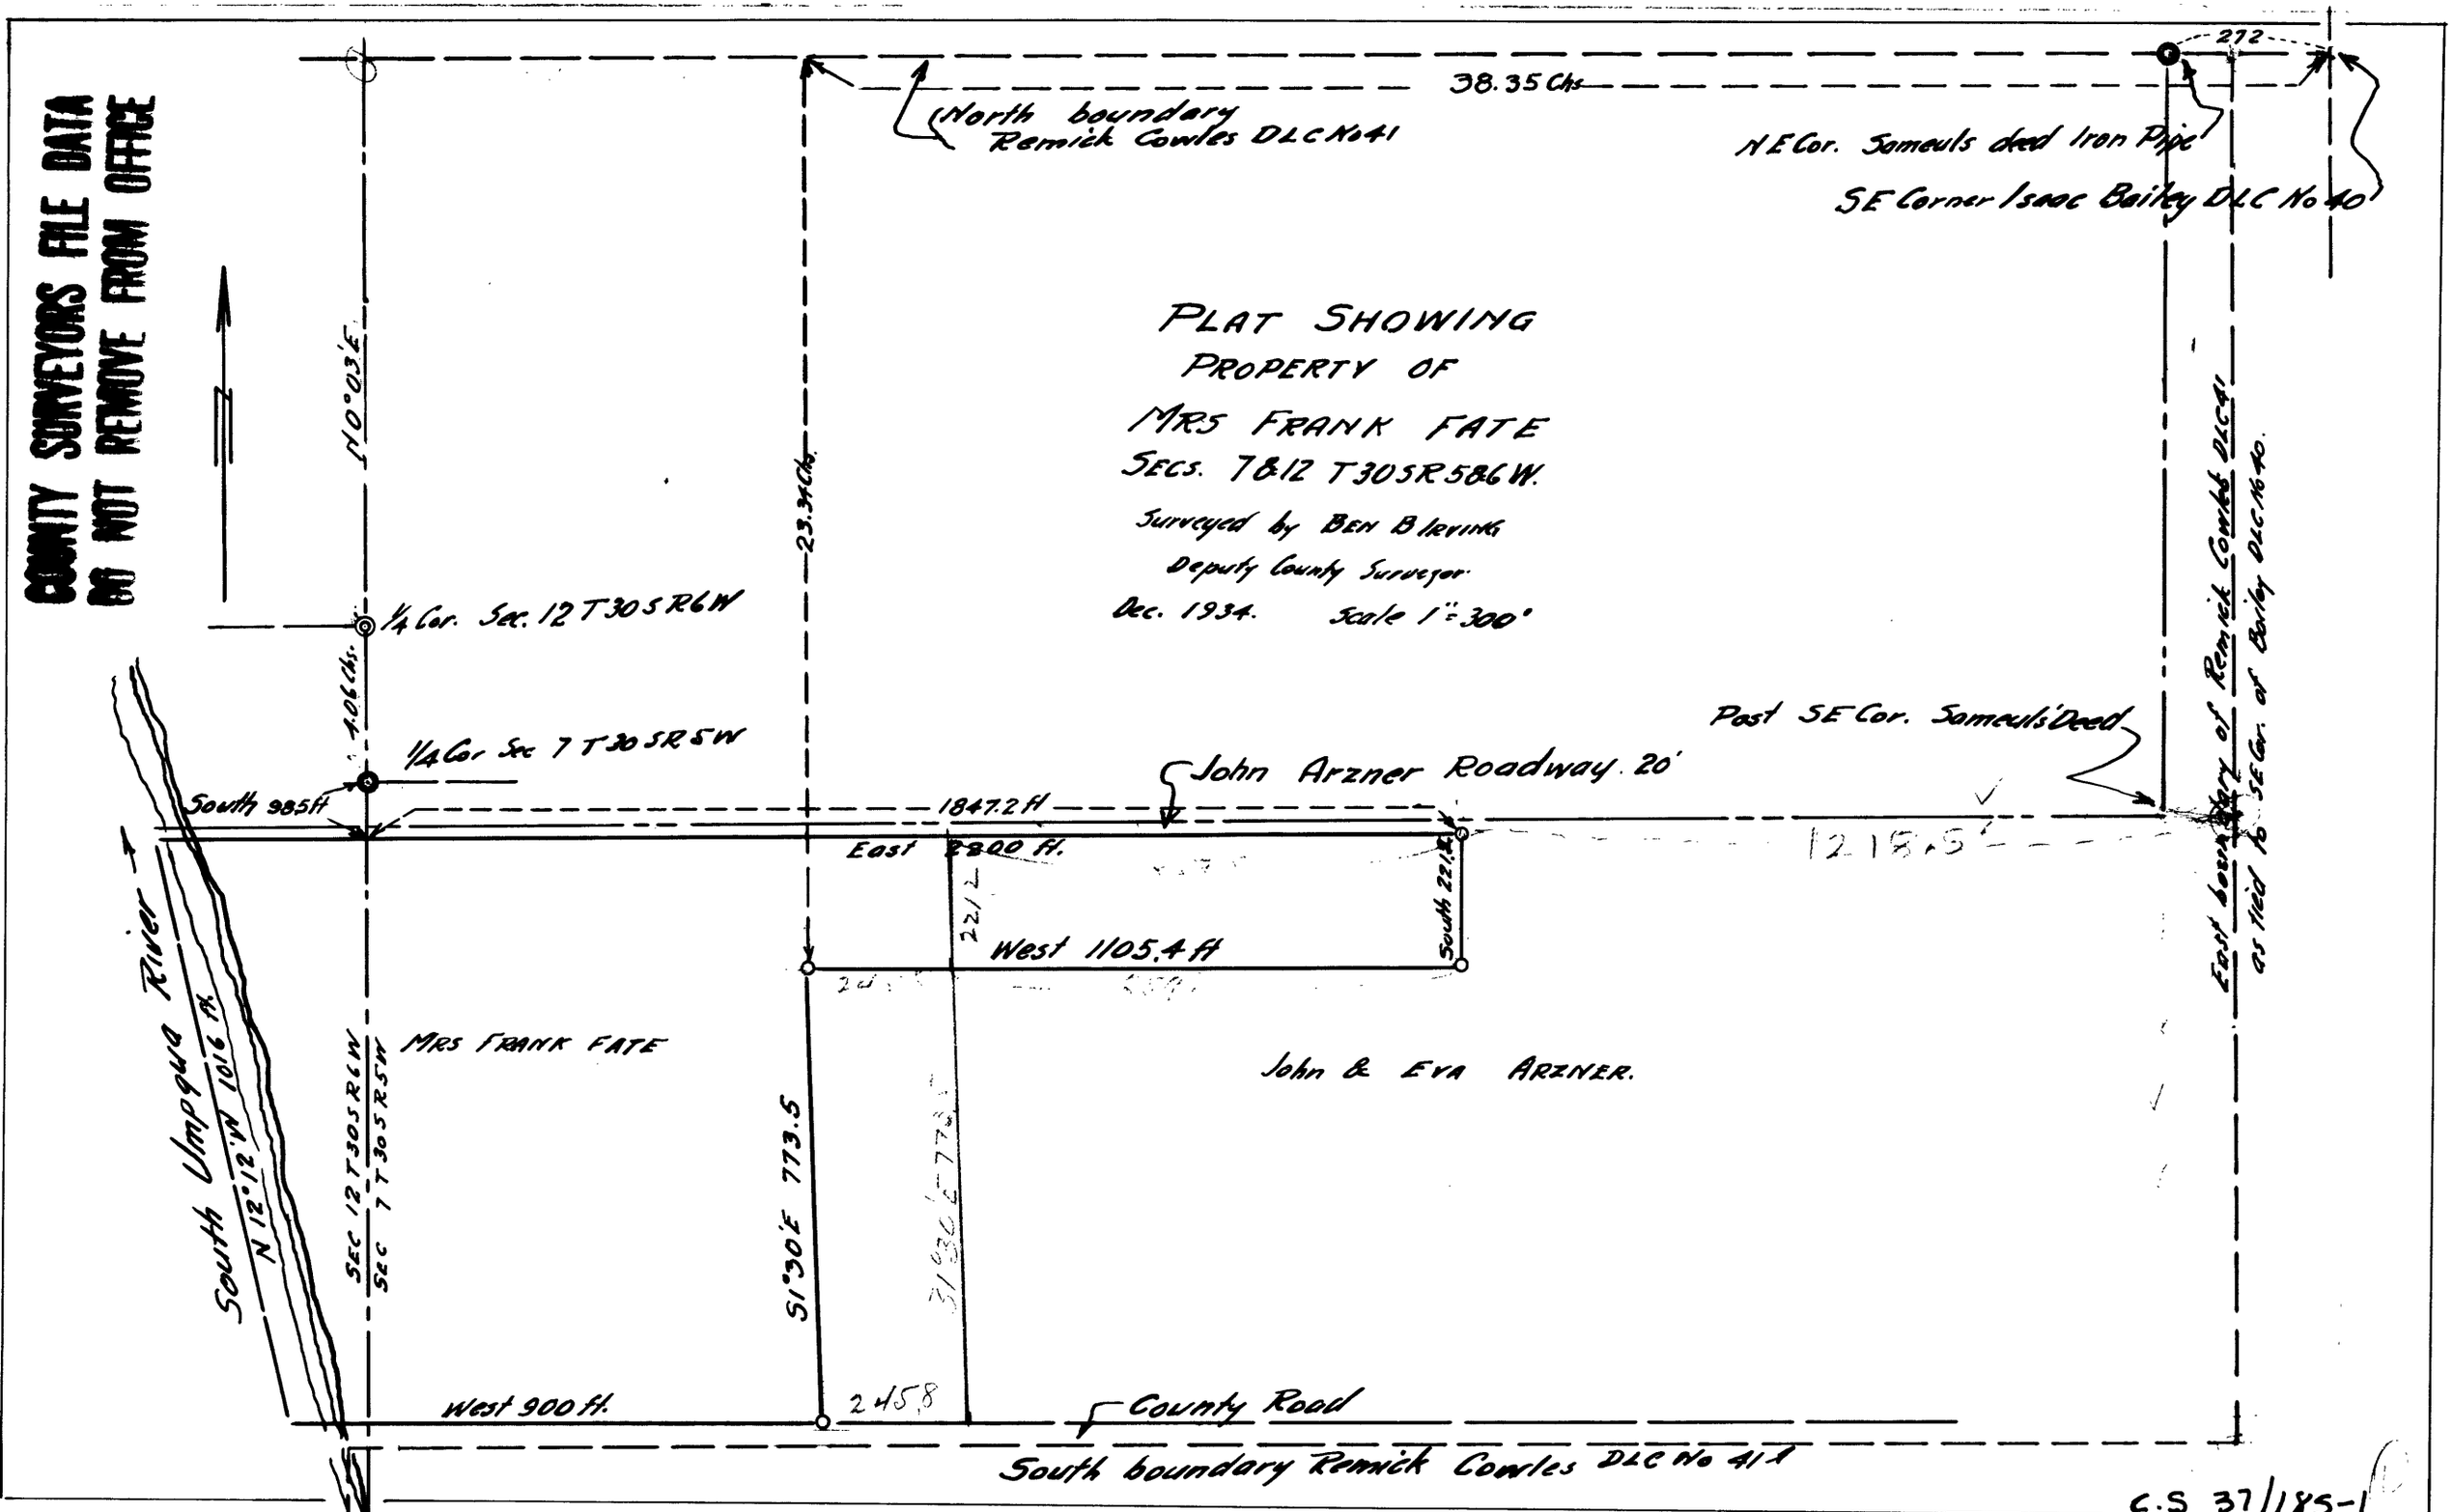

C.S 37/185-1
FILE 185 DRAWER 37