

SCALE 1" = 200'

H.O.L.C. No 9156 LLOYD M. STUMBO,  
 Box 1263, ROSEBURG, OREGON


All of Lots 1 & 2 in BLOCK 12 of PLAT D of the OMAHA  
 PARK FRUIT LANDS, according to the plat thereof as the same is of  
 file and of record in the office of the COUNTY CLERK for  
 DOUGLAS COUNTY, OREGON.

**COUNTY SURVEYORS FILE DATA  
 DO NOT REMOVE FROM OFFICE**

I, BEN B. IRVING, hereby certify that I have surveyed the property  
 above described and that the above plat illustrates the conditions as to  
 improvements and encroachments, if any, existing on this date.

Nov 10 1934

*Ben B. Irving*  
 Registered Professional Engineer.

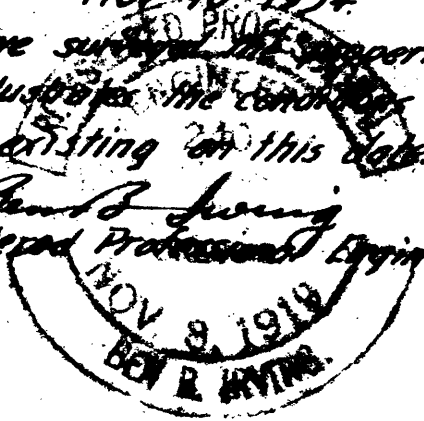

STATE OF OREGON No. 240  
 NOVEMBER 8, 1919

CS 37/206-5