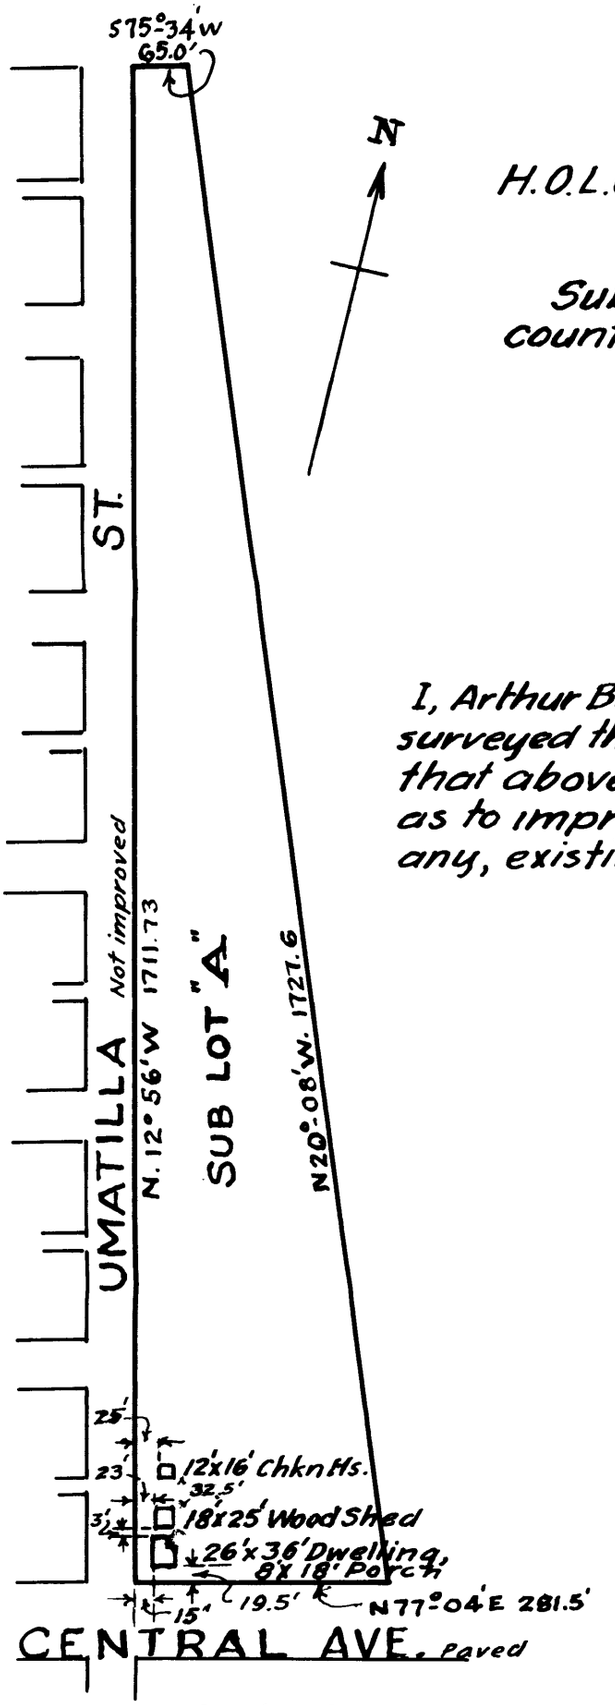

Scale, 1" = 200 ft.

H.O.L.C. 11830 Dunlap, I.A., Central Ave., Sutherlin, Ore.

Sub Lot A of Sutherlin, Douglas county, Oregon.

Roseburg, Ore. Oct. 14, 1935.

I, Arthur Boyer, do hereby certify that I have surveyed the property above described and that above plat illustrates the conditions as to improvements and encroachments, if any, existing on this date.

Arthur Boyer
Registered Prof. Eng'r.
State of Oreg. Lic. 1581, May 5, 1933.

COUNTY SURVEYORS FILE DATA
DO NOT REMOVE FROM OFFICE

C.S. 37/210-1

FILE 210-DRAWER 37