COUNTY SURVEYORS FILE DATA
DO NOT REMOVE FROM OFFICE

REGISTERED
OREGON
LAND SURVEYOR

Geo. J. Wenderoth

MARCH 10, 1944
George J. Wenderoth
5

Deputy County Surveyor

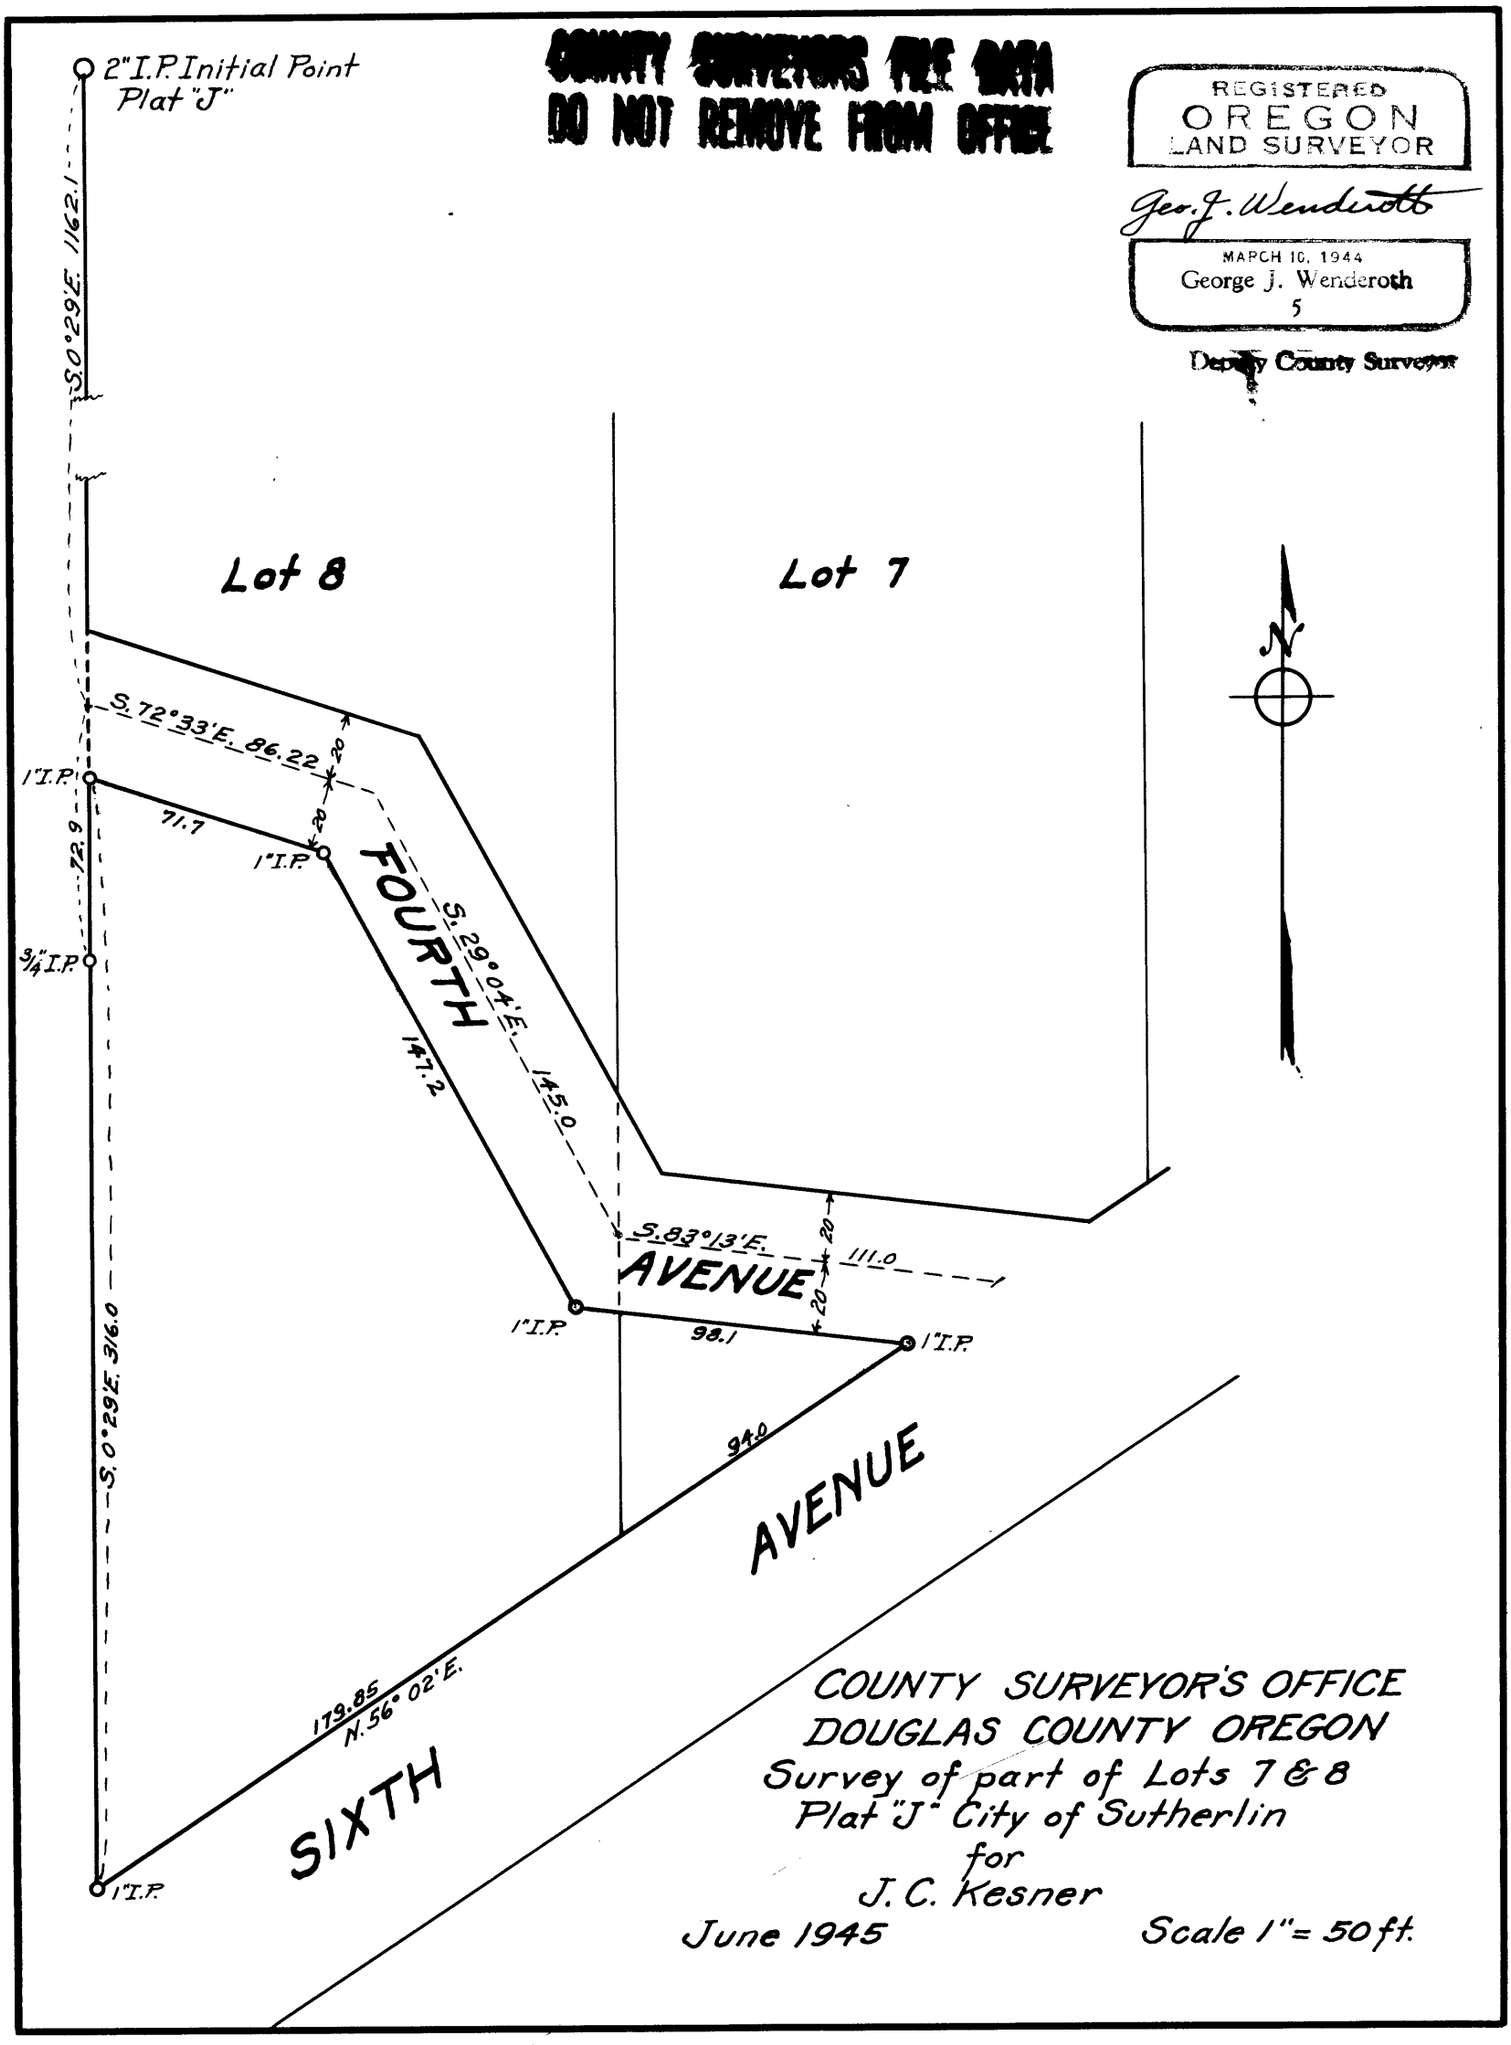

COUNTY SURVEYOR'S OFFICE
DOUGLAS COUNTY OREGON
Survey of part of Lots 7 & 8
Plat "J" City of Sutherlin
for
J. C. Kesner
June 1945 Scale 1" = 50 ft.

FILE 16 DRAWER 38